Paper weight-110# (minimum)

Black nonfading ink required


LAND U.S. SURVEY **PUBLIC** MONUMENT RECORD

For Public Land Survey Corners In:

WI ADMINISTRATIVE CODE A-E 7.08 REQUIREMENT

T. 4 N. R. 11 E. 4th P.M.

CORNER CODE INDEX

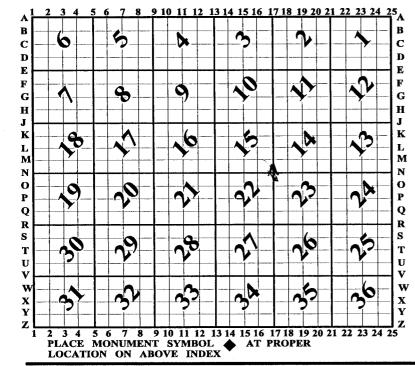

PORTER TWP **ROCK COUNTY WI**

IF AVAILABLE ROCK COUNTY COORDINATES PERFERRED

North	Elev.
East	
Hor. Datum	Vert. Datum
LATITUDE	ELLIPS. HT.
LONGITUDE	
NAD83(91)	NETWORK ADJ. YR
GPS (X)	TRAVERSE (X)
BASED ON TH	E FOLLOWING CONTROL:

◆ CORNER MONUMENT

O WITNESS MONUMENT

BEARINGS ARE BASED ON:_

(a)

			>_
FIELD BOOK PAGE #	SHEET	OF	B
SHOW A PLAN VIEW DRAWING DEPICTING THE CORNER MONUMENT AN PHYSICAL FEATURES, INCLUDING THE EXCAVATION AREA AND DEPTH.	D SURROUNI	DING	
PLANNING & ZONING COMMITTEE ADOPTED THIS FORM ON 12/2/1982 CORNER	CODE	N-1-	7

PD569 NE-COR-SEC-22

(B) Describe any record evidence, monument evidence, occupational evidence, testimonial evidence or any other material evidence you considered, and whether the monument was found or placed.

1833 HARRISON (NOV 3RD) $T4NR11E4^{TH}MER$. NORTH BET. 22 & 23

1694.22 BURR DAK 18

2640.0 SET POST FOR COR TO QUARTER SEC IN

EDGE OF ???? & ENTER PRAIRIE BURR OAK 10 S69W 76.56'; BURR OAK 10 S16E

112.2' BURR DAK 10; BURR DAK

10}MARKED

4521.0 ROAD TO DOUGHERTY'S FURNANCE W.

4620.0 66' WEST OF LI? (NAME) SPRING NORTH

5280.0 SET POST FOR COR TO SECS 22,23,14,15 MARKED & RAISED A MOUND LAND 1 $^{\rm ST}$ 1/4 MILE ROLLING 2 $^{\rm ND}$ RATE WITH BURR OAK

TIMBER GRASS & WEEDS - LAST 1/2

ROLLING 1ST RATE PRAIRIE

1833 HARRISON (OCT 29TH) TAN R11E 4TH MER. NORTH

BET. 14 & 15

667.26 BROOK 3.3' CRS N.E.

2640.0 QUARTER SEC COR.

POST & RAISED MOUND OF EARTH & SOD

5280.0 SET COR TO SECS 10,11,14, 15

MARKED POST & RAISED MOUND OF

EARTH & SOD

LAND ROLLING 1ST RATE PRAIRIE GROWTH

GRASS & WEEDS

1833 HARRISON (NOV) TAN RIIE 4TH MER. EAST ON RAND.

BET. 15 & 22

2640.0 TEMPY 1/4 SEC COR

4521.0 BROOK 5.28' CRS NORTH

5330.16 INT. EAST BDY 26.40' NORTH OF POST

LAND GENTLY ROLLING PRAIRIE

DESCENDING EAST TO BROOK GROWTH

GRASS & WEEDS

WEST COR. WEST

2665.08 QUARTER SEC COR. {POST & RAISED

MOUND OF EARTH & SOD

5330.16 SEC COR

1833 HARRISON (NOV) TAN R11E 4TH MER. EAST

BET. 14 & 23

2640.0 TEMPY 1/4 SEC COR

4620.0 LEFT PRAIRIE & ENTER TIMBER

5324.88 INT. EAST BDY 7.92' SOUTH OF POST

LAND 1ST RATE ROLLING PRAIRIE GROWTH

GRASS & WEEDS

WEST COR WEST

2662.44 QUARTER SEC COR SET A POST AND

RAISED A MOUND

5324.88 SEC COR

1885 RUGER VOL 2 PG 293 STATES NOTHING ABOUT MON. CALLS

FOR VAR 5-50 2639.01 TO W 1/4 COR SEC 23

1970 WIDOT CTH M #13072

1977 BARNES VOL 5 PG 253 SET ALUM. MON. & REFERENCED

SAME. MON IS 0.5' WEST OF N/S FENCE, 1.5 SOUTH OF E/W FENCE. DUG & FD NOTHING SET AT RECORD DISTANCE

(RUGER) FROM W 1/4 COR & NE COR SEC 23.

1977 BARNES VOL 5 PG 255 BARNES VOL 5 PG 255 I

TRAVERSED SEC 23. RESULTS INDICATE RUGER DIVIDED THE SECTION BY INTERSECTING THE E/W 1/4 INE AND THE N/S 1/4 LINE. BATTERMAN JR. AGREED THAT THE SW COR OF THE NE 1/4 OF THE NE 1/4 AND THE NW COR OF THE NE 1/4 OF THE NE 1/4 WERE ERRONEOULY FOUND. THE

HIGHWAY RECORDS.

CORNER CODE N-17

SHEET 1 OF \$72

Dull Brens Apr 29,2010

PO569 NE-COR-SEC-22

THE S 1/16TH COR OF THE NE 1/4, THE OCCUPATION LINE, ANT THE CORNER'S LOCATION TO THE N 1/4 COR AND THE NE COR INDICATE THE N 1/6 COR SHOULD BE SET ON PG VOL 5 PG 254. THE NE COR WAS SET BY PROJECTING THE E 1/4 COR AND THE FENCE INTERSECTION AT THE E 1/16 COR OF THE NE 1/4 AT RECORD DISTANCE. THIS POINT AGREED WITH THE RECORD DISTANCE TO THE OCCUPATION TO THE NW CORNER.

S89-43-53E 2724.44 TO N 1/4 COR SEC 23, S0-57-32W 2639.01 TO W 1/4 COR SEC 23, 5448.95 TO NE COR SEC 23.

- 1977 BARNES VOL 6 PG 398 N89-52-56E 2724.45 TO N 1/4 COR SEC 23, WHICH IS MIDWAY & ON LINE WITH THE NE COR SEC 23, SOO-34-33W 2639.01 TO W 1/4 COR SEC 23, ANGLE 90-41-38 @ NW COR SEC 23 FROM N 1/4 COR SEC 23 TO W 1/4 COR SEC 23
- 1989 LEE #12002 ALUM. 2654.04 TO SET 3/4X48" PIN @ E 1/4 COR SEC 15, 5308.09 TO FD RR @ NE COR SEC 15.

FD ALUM. MON. of TIES

C) Was the corner restored through acceptance of (1) an obliterated evidence location, or, (2) a found perpetuated location?

ACCEPTED FD ALUM.

D) Describe any material discrepancy between the location of the corner as restored or reestablished and the location of that corner as previously restored or reestablished by distance and direction. Show the discrepancy on the plan view drawing under (a), above. Show the distances between the corner as previously restored or reestablished and (1) the corner as restored or reestablished, and (2) to at least 4 of the witness monuments shown on the drawing in (a), above.

NONE

(E) Was the corner reestablished through lost corner proportionate methods? If so, show the method, including the directions and distances to other public land survey corners used as evidence or used for proportioning the corner location.

I, **Donald Barnes**, hereby certify that the corner location as identified by the corner code index was determined by me under my direction and control and that this U.S. Public Land Survey Monument Record is correct and complete to the best of my knowledge and belief.

Barrer Bonboss Apre 29 2010

SHEET 2 OF 8

CORNER CODE N-17

A.E. 7.08 REQUIREMENT