

Paper weight-110# (minimum)

Black nonfading ink required

# U.S. PUBLIC LAND SURVEY MONUMENT RECORD

For Public Land Survey Corners In:

WI ADMINISTRATIVE CODE A-E 7.08 REQUIREMENT

T. 4 N. R. 11 E. 4th P.M.

REV 10/23/2004

USMONREC.DWG

CORNER CODE INDEX

**PORTER** TWP

**ROCK COUNTY WI**

IF AVAILABLE

ROCK COUNTY COORDINATES PREFERRED

A	1	2	3	4	5	6	7	8	9	10	11	12	13	14	15	16	17	18	19	20	21	22	23	24	25	A
B																										B
C																										C
D																										D
E																										E
F																										F
G																										G
H																										H
J																										J
K																										K
L																										L
M																										M
N																										N
O																										O
P																										P
Q																										Q
R																										R
S																										S
T																										T
U																										U
V																										V
W																										W
X																										X
Y																										Y
Z																										Z

North \_\_\_\_\_ Elev. \_\_\_\_\_

East \_\_\_\_\_

Hor. Datum \_\_\_\_\_ Vert. Datum \_\_\_\_\_

LATITUDE \_\_\_\_\_ ELLIPS. HT. \_\_\_\_\_

LONGITUDE \_\_\_\_\_

NAD83(91) \_\_\_\_\_ NETWORK ADJ. YR \_\_\_\_\_

GPS (X) \_\_\_\_\_ TRAVERSE (X) \_\_\_\_\_

BASED ON THE FOLLOWING CONTROL:

PLACE MONUMENT SYMBOL  AT PROPER LOCATION ON ABOVE INDEX

CORNER MONUMENT

WITNESS MONUMENT

(a)

BEARINGS ARE BASED ON: -----

FIELD BOOK \_\_\_\_\_ PAGE # \_\_\_\_\_

SHEET 1 OF 3

SHOW A PLAN VIEW DRAWING DEPICTING THE CORNER MONUMENT AND SURROUNDING PHYSICAL FEATURES, INCLUDING THE EXCAVATION AREA AND DEPTH.

PLANNING & ZONING COMMITTEE ADOPTED THIS FORM ON 12/2/1982

CORNER CODE P-17

PO578

E1/4CORSEC22

(B) Describe any record evidence, monument evidence, occupational evidence, testimonial evidence or any other material evidence you considered, and whether the monument was found or placed.

1833 HARRISON (NOV 3RD) T4N R11E 4<sup>TH</sup> MER. NORTH  
BET. 22 & 23

1694.22	BURR OAK 18
2640.0	SET POST FOR COR TO QUARTER SEC IN EDGE OF ???? & ENTER PRAIRIE BURR OAK 10 S69W 76.56'; BURR OAK 10 S16E 112.2' BURR OAK 10; BURR OAK 10}MARKED
4521.0	ROAD TO DOUGHERTY'S FURNANCE W.
4620.0	66' WEST OF LI? (NAME) SPRING NORTH
5280.0	SET POST FOR COR TO SECS 22,23,14,15 MARKED & RAISED A MOUND LAND 1 <sup>ST</sup> 1/4 MILE ROLLING 2 <sup>ND</sup> RATE WITH BURR OAK TIMBER GRASS & WEEDS - LAST 1/2 ROLLING 1 <sup>ST</sup> RATE PRAIRIE

1847 STEBBINS -PORTER TWP RD REC BK 1 PG 1 BEGINNING @ A POINT ON THE SOUTH LINE OF SEC 36 T4N R11E 1122' WEST OF THE SE COR OF SAID SECTION; THENCE N44 1/2W 3742.2' TO A STAKE; THENCE N56 1/2 W 3006.96' TO THE CENTER OF THE EAST AND WEST ROAD NEAR J. STEVENS; THENCE N40W 5016' TO STAKE; THENCE N34 1/2 W 2,344.98' TO THE SEC LINE BETWEEN 26 & 27 419.76' SOUTH OF THE NW COR OF SEC 26; THENCE NORTH ON SAID SECTION LINE AND THE BETWEEN 22 & 23 3059.76' TO THE 1/4 POST ON THE SEC LINE BETWEEN SECTION 22 & 23 OF SAID TOWN & RANGE AND THE WHOLE LENGTH OF THE ROAD IS 17,169.9' COURSES GIVEN ACCORDING TO THE TRUE MERIDIAN VARIATION OF NEEDLE 7-34. HARRISON STEBBINS-COUNTY SURVEYOR

1851 STEBBINS PORTER TWP ROAD REC BK#1 PG 4 BEGINNING AT A POINT ON THE HIGHWAY LEADING WEST FROM VAN PATTENS BRIDGE ACROSS SEC 10 & 8(9?), WHERE THE LINE WHICH DIVIDES THE NW 1/4 OF THE SEC 10 RUNNING NORTH AND SOUTH INTERSECTS SAID HIGHWAY; THENCE SOUTH ON SAID LINE 11,503.14' TO THE 1/4 LINE RUNNING EAST & WEST, THROUGH SEC 22 T4NR11E AND THE WHOLE LENGTH OF THE RD IS 11,501.82'. COURSES GIVEN ACCORDING TO THE TRUE MERIDIAN. VARIATION OF NEEDLE 7-3/4 HARRISON STEBBINS, SURVEYOR

1855 STEBBINS PORTER TWP RD REC BK 1 PG 7 BEGINNING AT THE 1/4 POST ON THE SEC LINE BETWEEN SECTIONS 22 AND 23; THENCE SOUTH ON THE SEC LINE 8,712' TO A POINT ON THE CENTER OF THE HIGHWAY RUNNING EASTERLY AND WESTERLY THROUGH SEC 34 & 35, SAID POINT BEING 792' SOUTH OF THE SW COR OF SEC 26, T4NR11E. THE LENGTH OF SAID ROAD IS 8712'; SAID ROAD IS 66 WIDE. COURSES GIVEN ACCORDING TO THE TRUE MERIDIAN. VARIATION OF NEEDLE 7 3/4. H. STEBBINS-SURVEYOR

1878 RUGER VOL 2 PG 241 FD SE BT & STUMP OF SW BT ALSO FD HH STONE 16X10X8 ON TOP OF LIMESTONE LAID FLAT AND REMAINS OF OLD STAKE UNDER STONES. REPLACED STAKE & STONES. VAR 6-35 TO SE COR SEC 22, 1310.43 TO N 1/16TH COR OF SE 1/4 SEC 22, 2620.86 TO HH 16X10X5 SURROUNDED BY 3 HHS @ CENTER OF SEC 22.

1885 RUGER VOL 2 PG 293 FD COR SET BY SELF IN FORMER SURVEY. USED TO SUBDIVIDE SEC 23

1940 SUNNY VOL 3 PG 467 E & W 1/4 COR OF SEC 22 & 23 DUG 7X7 HOLE 5' DEEP FD NOTHING. DIAGRAM SHOWS HOLE @ CENTER OF RD INTERSECTION.

1968 BATTERMAN VOL 4 PG 447 STATES NOTHING ABOUT MON. REFERENCED COR. ADDED WIDOT REF. DRAWING

*D. J. [Signature]*  
3-20-2009

PO578 E1/4CORSEC22

- 1970 WIDOT CTH M #13072 SHOWS BUT DID NOT USE OR STATE ANYTHING ABOUT THE MON. SHOWS SAME TIES AS IN VOL 4 PG 477
- 1975 COMBS CSM VOL 4 PG 345 FD MON. 2621.50 TO FD STONE @ CENTER OF SEC 22.
- 1976 COMBS CSM VOL 5 PG 343 FD MON. WEST 2621.50 TO FD STONE @ CENTER OF SEC 22.
- 1976 DOT #3616 TIE PENCELED IN VOL 4 PG 447 STATES NOTHING ABOUT MON. SET 3 REF. CONC. MON.
- 1977 BARNES VOL 5 PG 250 SHOWS AS 48 SOUTH OF CENTER LINE PVMT OF CTH M. FD CI & REFERENCED SAME.
- 1977 BARNES VOL 5 PG 255 BARNES VOL 5 PG 255 I TRAVERSED SEC 23. RESULTS INDICATE RUGER DIVIDED THE SECTION BY INTERSECTING THE E/W 1/4 INE AND THE N/S 1/4 LINE. BATTERMAN JR. AGREED THAT THE SW COR OF THE NE 1/4 OF THE NE 1/4 AND THE NW COR OF THE NE 1/4 OF THE NE 1/4 WERE ERRONEOUSLY FOUND. THE HIGHWAY RECORDS, THE S 1/16TH COR OF THE NE 1/4, THE OCCUPATION LINE, ANT THE CORNER'S LOCATION TO THE N 1/4 COR AND THE NE COR INDICATE THE N 1/6 COR SHOULD BE SET ON PG VOL 5 PG 254. THE NE COR WAS SET BY PROJECTING THE E 1/4 COR AND THE FENCE INTERSECTION AT THE E 1/16 COR OF THE NE 1/4 AT DISTANCE TO THE OCCUPATION TO THE NW CORNER. RECORD DISTANCE. THIS POINT AGREED WITH THE RECORD. S89-36-48E 2719.32 TO CENTER OF SEC 23, S89-36-48E 5433.42 TO E 1/4 COR SEC 23, NO-57-32E 2639.01 TO NE COR SEC 23.
- 1977 BARNES VOL 6 PG 398 NO-34-33E 2639.01 TO NW COR SEC 23, NB9-59-17E 2720.35 TO GEN SEC 23, 5434.37 TO E 1/4 COR SEC 23, ANGLE 89-24-45 @ W 1/4 COR SEC 23 FROM NW TO GEN OF SEC 23.
- 1979 BARNES VOL 5 PG 548 SHOWS AS EAST OF EAGLE RD SO-29-02W 2649.33 TO SW COR SEC 23. KARNS SURVEY
- 1982 SCHROEDER CSM 10-550 STATES NOTHING ABOUT MON
- 2000 COMBS #7655 SIZE 2 SEC 22

CI MON APPEARS TO HAVE BEEN HIT AND DISTORTED. THIS MAY HAVE BEEN BY A SNOW PLOW BLADE. THE RECORD DISTANCES TO THE FOUND WIDOT DISKS IN CONC. AND FD PIPES ARE IN HARMONY.

C) Was the corner restored through acceptance of (1) an obliterated evidence location, or, (2) a found perpetuated location?

ACCEPTED THE INTERSECTION OF THE REFERENCE MONUMENTS AS THE CORNER. SINCE THE CI MON. APPEARS TO HAVE BEEN HIT, I DID NOT ACCEPT IT. LOCATION IS IN HARMONY WITH RUGER'S MEASUREMENTS.

D) Describe any material discrepancy between the location of the corner as restored or reestablished and the location of that corner as previously restored or reestablished by distance and direction. Show the discrepancy on the plan view drawing under (a), above. Show the distances between the corner as previously restored or reestablished and (1) the corner as restored or reestablished, and (2) to at least 4 of the witness monuments shown on the drawing in (a), above.

YES - SEE SKETCH

I, Donald Barnes, hereby certify that the corner location as identified by the corner code index was determined by me under my direction and control and that this U.S. Public Land Survey Monument Record is correct and complete to the best of my knowledge and belief.

Seal  
 Donald  
 Barnes  
 3-20-2009


SHEET 2 OF 3

CORNER CODE P-17

A.E. 7.08 REQUIREMENT

Donald Barnes

3-20-2009

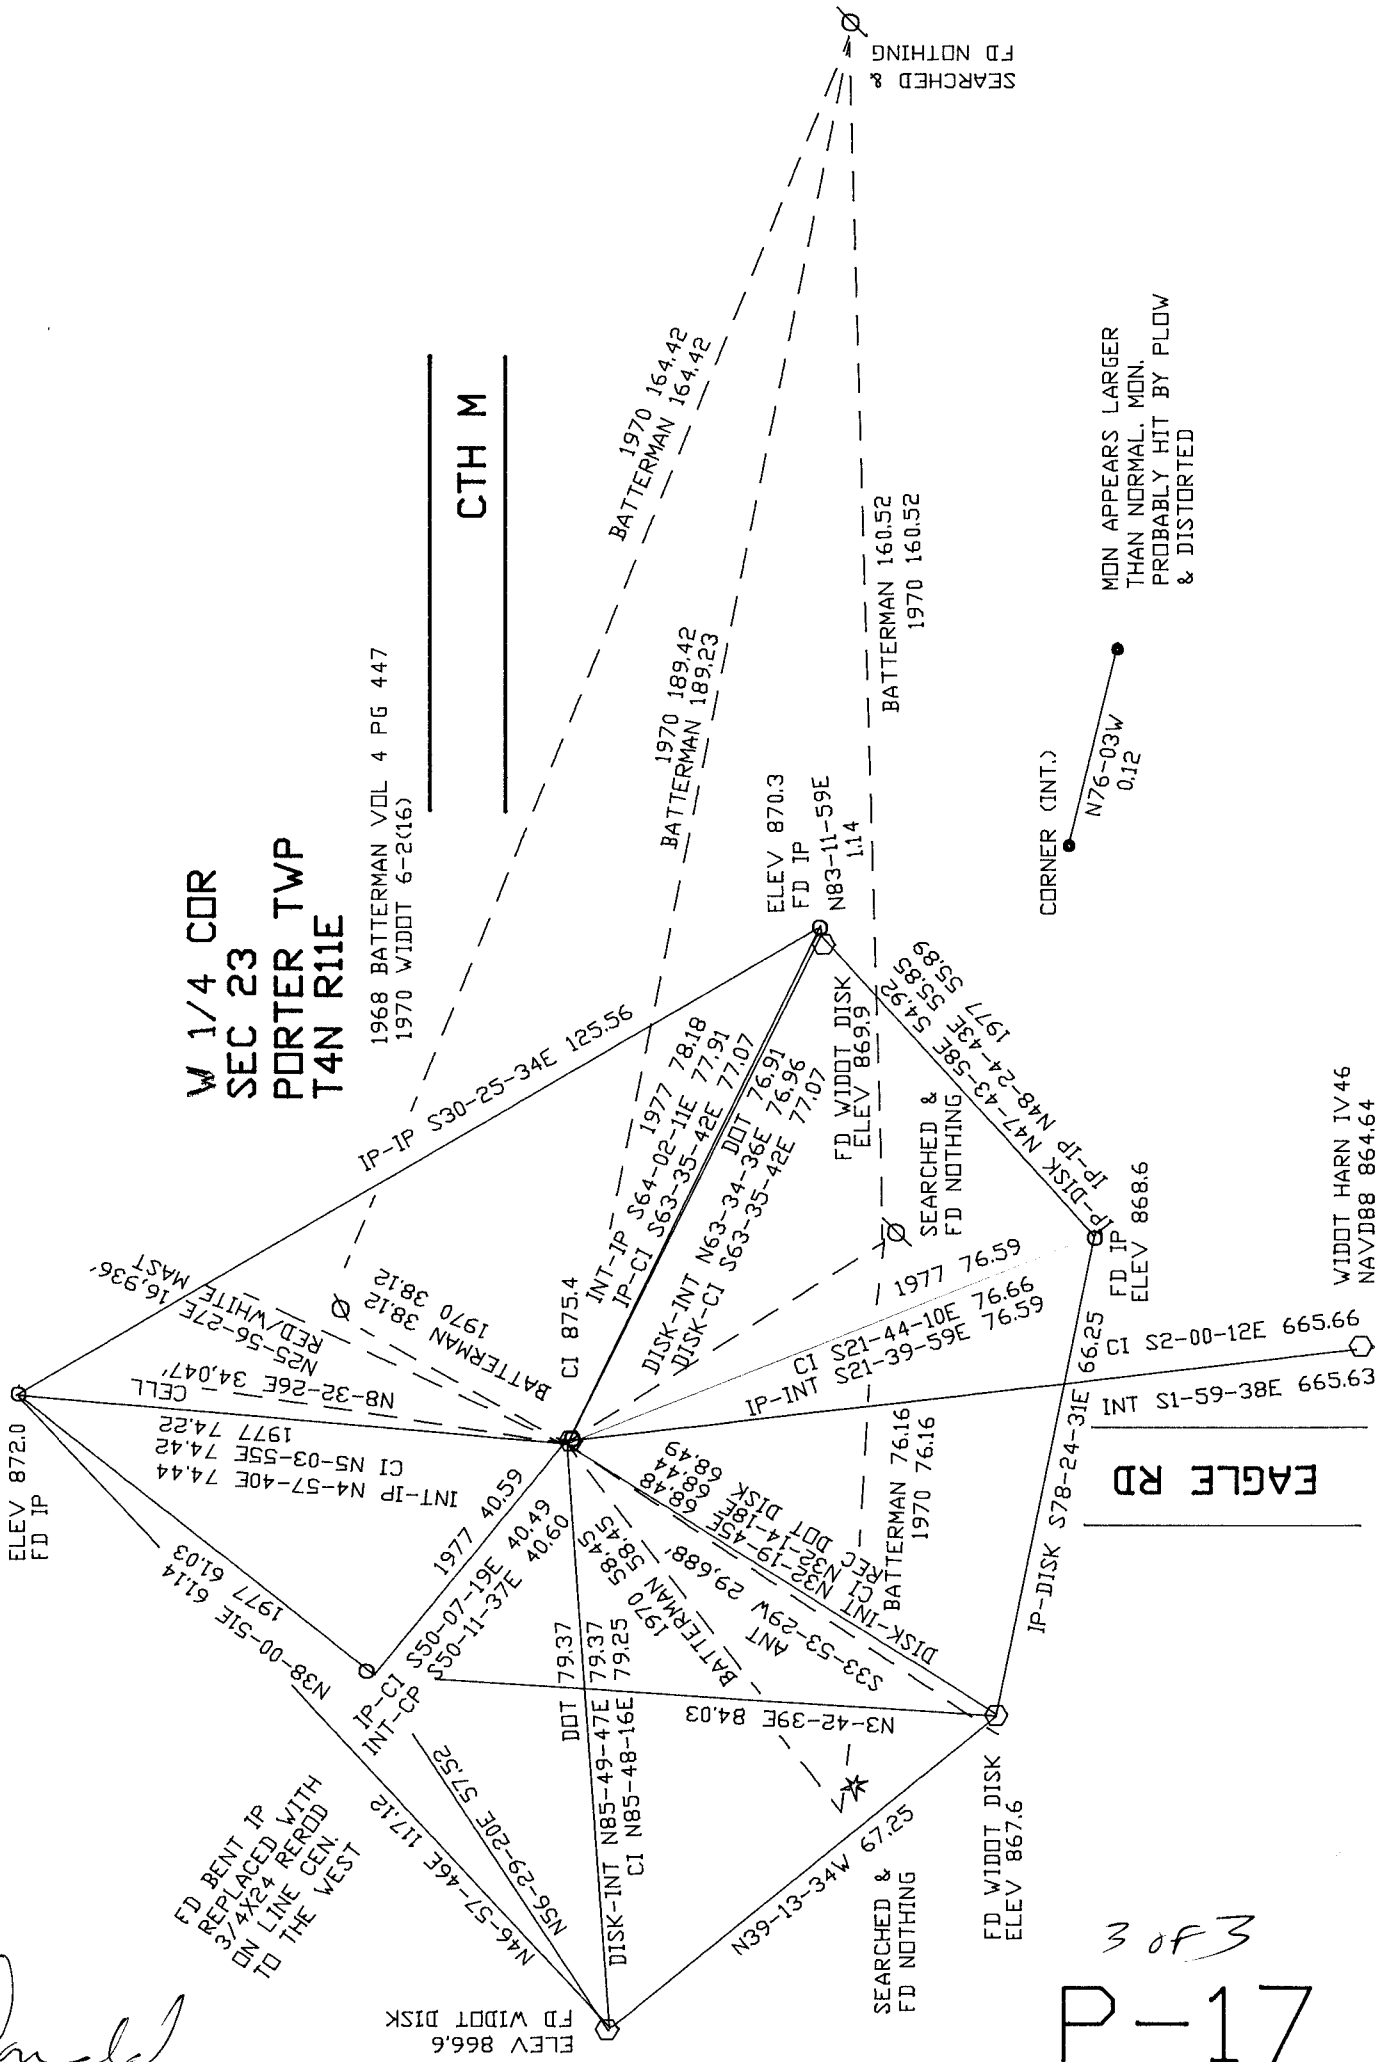

MON APPEARS LARGER THAN NORMAL. MON. PROBABLY HIT BY PLOW & DISTORTED

CORNER (INT.)  
N76-03W  
0.12

EAGLE RD

3 of 3

P-17