Paper weight-110# (minimum)

Black nonfading ink required

U.S. PUBLIC LAND SURVEY MONUMENT RECORD


For Public Land Survey Corners In:

WI ADMINISTRATIVE CODE A-E 7.08 REQUIREMENT

EV 10/23/2004 USMONREC.DWG

T. <u>4</u> N. R. <u>11</u> E. 4th P.M.

CORNER CODE INDEX

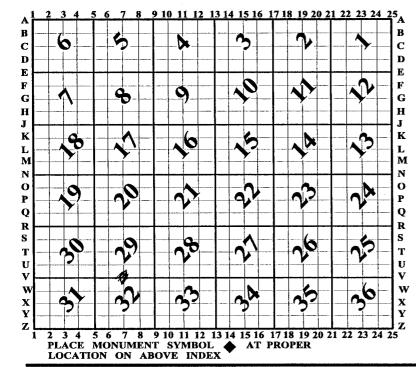

PORTER TWP

IF AVAILABLE
ROCK COUNTY COORDINATES PERFERRED

North	Elev.
East	
Hor. Datum	Vert. Datum
LATITUDE _	ELLIPS. HT.
LONGITUDE	
NAD83(91)	NETWORK ADJ. YR
GPS (X)	TRAVERSE (X)
BASED ON TH	E FOLLOWING CONTROL:

◆ CORNER MONUMENT

WITNESS MONUMENT

BEARINGS ARE BASED ON:

(a)

FIELD BOOK _____ PAGE # ____ SHEET ___ OF ___ SHOW A PLAN VIEW DRAWING DEPICTING THE CORNER MONUMENT AND SURROUNDING PHYSICAL FEATURES, INCLUDING THE EXCAVATION AREA AND DEPTH.

PLANNING & ZONING COMMITTEE ADOPTED THIS FORM ON 12/2/1982

CORNER CODE _______

P0604

S1/4CORSEC29

(B) Describe any record evidence, monument evidence, occupational evidence, testimonial evidence or any other material evidence you considered, and whether the monument was found or placed.

1833 HARRISON (NOV) TAN R11E 4TH MER. EAST ON

RANDOM BET. 29 & 32

2640.0 TEMPY 1/4 SEC COR.

5289.90 INT E BDY 23.10' NORTH OF POST LAND @ SAME

WEST COR WEST BET. 29 & 32

2644.95 QUARTER SEC COR. {BURR OAK 14 55E 50.16'; BURR OAK 14 562E 9.24'} {BURR OAK 14; BURR OAK 14} MARKED

5289.90 SEC COR

- PORTER TWP RD REC BK 1 PG 1 BEGINNING AT A POINT ON THE ROAD LEADING FROM JANESVILLE TO MADISON 165' SOUTH OF THE CENTER OF SEC 32 T4N R11E; THENCE NORTH ON THE CENTER LINE OF SEC 32 TO THE 1/4 POST ON THE NORTH LINE OF SAID SEC; THENCE NORTH ON THE CENTER LINE OF SEC 29 TO THE 1/4 POST ON THE NORTH LINE OF 29; THENCE NORTH; THENCE NORTH ON THE CENTER OF THE ROAD RUNNING EAST AND WEST THROUGH SAID SECTION. THE LENGTH OF SAID RD IS 12,837.0'. COURSES GIVEN ACCORDING TO THE TRUE MERIDIAN. VARIATION OF NEEDLE 7-3/4
- 1871 RUGER VOL 2 PG 68 ESTABLISHED SEC CORS DROVE STAKE DEEP & PUT ON TOP OF IT HH STONE 18X9X8 & SURROUNDED IT WITH 4 HHS VAR7-07 1329.74 TO HH 13X10X8 @ S 1/16TH COR OF SE 1/4 SEC 29, 2659.47 TO SE COR SEC 29, VAR 7-07 2659.47 TO SW COR SEC 29, VAR 7-28 2668.05 TO HH 15X10X6 @ CENTER OF SEC 29
- 1875 RUGER VOL 2 PG 184 SEE PG 41 VAR 6-30 2656.83 TO CENTER OF SEC 32
- 1976 BARNES VOL 5 PG 201 FB#1 PG 17 FD HH 18X9.5X8
 SURROUNDED BY 3 HHS 1' DEEP UNDER HH FD BARB WIRE.
 SHORT PK TIES; 10.00 TO SE & 15.00 TO NE. REFERENCED
 SAME. COR IS 2.8 EAST OF WEST PVMT EDGE, ON LINE E/W
 FENCE TO WEST, & BB +/- NORTH OF CENTER OF CULVERT.
- 1977 BARNES VOL 5 PG 265 FB#1 PG 53 SET ALUM. MON.
- 1978 PHILLIPSON CSM VOL 8 PG 258 STATES NOTHING ABOUT MON.
- 1979 BARNES FB#2 PG 1 & 2 FD ALUM. TRAV. TO IT.
- 1979 BARNES VOL 5 PG 567 FD ALUM MON. N2-44-00W 2673.91 TO CEN SEC 29M N2-44-00W 5322.78 TO N 1/4 COR SEC 29
- 1990 SCHROEDER CSM VOL 14 PG 257
- 1993 KARNS CSM VOL 16 PG 268 ROCK COUNTY MON. 5323.34 TO 5 1/4 COR SEC 32
- 1994 KARNS CSM VOL 17 PG 245 ROCK COUNTY MON. 5323.17 TO S 1/4 COR SEC 32
- 1994 KARNS CSM VOL 17 PG 246 ROCK COUNTY MON.

FD ALUM. MON & NE REFERENCE MONUMENT

SHEET 1 OF 3 CORNER GODE V-7 3-19-2009

PO604 S1/4CORSEC29

C) Was the corner restored through acceptance of (1) an obliterated evidence location, or, (2) a found perpetuated location?

ACCEPTED FD ALUM, MON.

D) Describe any material discrepancy between the location of the corner as restored or reestablished and the location of that corner as previously restored or reestablished by distance and direction. Show the discrepancy on the plan view drawing under (a), above. Show the distances between the corner as previously restored or reestablished and (1) the corner as restored or reestablished, and (2) to at least 4 of the witness monuments shown on the drawing in (a), above.

NONE

(E) Was the corner reestablished through lost corner proportionate methods? If so, show the method, including the directions and distances to other public land survey corners used as evidence or used for proportioning the corner location.

YES IN 1871 RUGER SET THE CORNER MIDWAY & ON LINE WITH THE NE & NW CORNERS OF SEC 32.

I, **Donald Barnes**, hereby certify that the corner location as identified by the corner code index was determined by me under my direction and control and that this U.S. Public Land Survey Monument Record is correct and complete to the best of my knowledge and belief.

o anel

SHEET 2 OF 3

3-19-2009

CORNER CODE V-7

A.E. 7.08 REQUIREMENT

