Paper weight-110# (minimum)

Black nonfading ink required

## LAND U.S. **PUBLIC**

SURVEY MONUMENT RECORD


For Public Land Survey Corners In:

WI ADMINISTRATIVE CODE A-E 7.08 REQUIREMENT

REV 10/23/2004 USMONREC.DWG

T. 4 N. R. 11 E. 4th P.M.

CORNER CODE INDEX

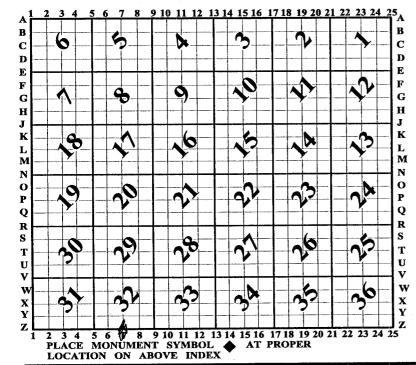

## **PORTER** TWP **ROCK COUNTY WI**

IF AVAILABLE ROCK COUNTY COORDINATES PERFERRED

North	Elev
East	
Hor. Datum	Vert. Datum
LATITUDE _	ELLIPS. HT.
LONGITUDE	
NAD83(91)	NETWORK ADJ. YR
GPS (X)	TRAVERSE (X)
BASED ON TH	E FOLLOWING CONTROL:

**♦ CORNER MONUMENT** 

WITNESS MONUMENT

BEARINGS ARE BASED ON:\_

(a)

		/	>
FIELD BOOK PAGE #	SHEET .	OF	<u>S</u> _
SHOW A PLAN VIEW DRAWING DEPICTING THE CORNER MONUMENT AN	ID SURROUND	ING	
PHYSICAL FEATURES, INCLUDING THE EXCAVATION AREA AND DEPTH.			
PLANNING & ZONING COMMITTEE ADOPTED THIS FORM ON 12/2/1982		<b>-</b>	_
CODING	CODE	7 -	/

(B) Describe any record evidence, monument evidence, occupational evidence, testimonial evidence or any other material evidence you considered, and whether the monument was found or placed.

- 1833 (SEP 15) MULLETT & BRINK TAN R11E 4<sup>TH</sup> MERIDIAM WEST ON SOUTH SIDE SEC 32
  - 2640.0 SET QUARTER SECTION POST BURR OAK 14 N24E 8.58'; BUR OAK 8 N81W 21.12'
  - 3663.0 ENTER WET PRAIRIE
  - 5280.0 SET POST CORNER SECTIONS 31 & 32 BUR
    OAK 12 N41E 74.58'; BUR OAK 6 N11W 11.22'
    LAND & SAME AS LAST MILE
- 1833 ORIG GOV PLAT NW COR SEC 4 CENTER TWP IS 6.60' WEST OF SW COR SEC 33 PORTER TWP.
- 1833 ORIG GOV PLAT NW COR SEC 5 CENTER TWP IS 7.92 WEST OF SW COR SEC 32 PORTER TWP.
- 1847 PORTER TWP RD REC BK 1 PG 1 BEGINNING AT A POINT ON THE ROAD LEADING FROM JANESVILLE TO MADISON 165' SOUTH OF THE CENTER OF SEC 32 T4N R11E; THENCE NORTH ON THE CENTRE LINE OF SEC 32 TO THE 1/4 POST ON THE NORTH LINE OF SAID SEC; THENCE NORTH ON THE CENTER LINE OF SEC 29 TO THE 1/4 POST ON THE NORTH LINE OF 29; THENCE NORTH; THENCE NORTH ON THE CENTERLINE OF SEC 20 4768.5 TO A POINT ON THE CENTER OF THE ROAD RUNNING EAST AND WEST THROUGH SAID SECTION. THE LENGTH OF SAID RD IS 12,837.0'. COURSES GIVEN ACCORDING TO THE TRUE MERIDIAN. VARIATION OF NEEDLE 7-3/4
- 1874 RUGER VOL 2 PG 165 & #3652 FD OLD STAKE & STUMP OF NW BT & WHERE STUMP OF NE BT HAD BEEN DUG UP.
  DROVE STAKE SURROUNDED IT WITH HH STONES. VAR 7-25
  2659.80 TO SW COR SEC 32. S 1/4 COR SEC 31, SE COR SEC 31 ARE ON LINE WITH S 1/4 COR SEC 32 & THE SW COR OF SEC 31.
- 1875 RUGER VOL 2 PG 184 & #702 SEE PG 121 THE 1/4 COR FOR CENTER TWP IS 0.99' (1 1/2 LINKS) WEST OF THE 1/4 COR FOR PORTER TWP. VAR 6-30 2486.88 ALONG N/S 1/4 LINE OF SEC 32 TO CENTER LINE OF HIGHWAY, VAR 6-30 2658.15 TO CENTER OF SEC 32, VAR 6-30 5314.98 TO N 1/4 COR SEC 32.
- 1875 RUGER VOL 2 PG 185 SEE PAGE 121 0.99' EAST OF N 1/4 COR SEC 5
- 1931 SUNNY VOL 3 PG 192 SET PIPE UNDER FENCE. 28' EAST OF RD. QUESTION IS THIS THE CORNER. WEST 1334.4 TO N/S FENCE & EAST 918.9 TO PIPE.
- 1931 SUNNY #3655 STATES NOTHING ABOUT MON. SHOWS
  WESTERLY 1334.4 TO N/S FENCE LINE, EASTERLY 918.9 TO
  SET PIPE WHICH IS 12 EAST OF N/S FENCE. NEAR COR
  CALLS FOR A SET PIPE 28' OF THE COR.
- 1931 SUNNY #700 CENTER TWP SET PIPE 28 EAST OF PVMT CENTER. CENTER OF ROAD WEST TO N/S FENCE LINE IS 1334.4', EAST OF CENTER OF ROAD 918.9 TO SET PIPE ON SEC LINE, EAST 1671.5 FROM CENTER OF ROAD TO N/S FENCE LINE, EAST 2662.5 FROM CENTER OF ROAD TO N/S FENCE LINE.
- 1976 BARNES VOL 5 PG 200 DUG & FOUND 1' DEEP ROTTED STAKE SURROUNDED BY 3HH & AT N 1/4 COR SEC 5 FD ROTTED STAKE. REFERENCED SAME. S 1/4 COR SEC 32 IS 0.80 EAST OF N 1/4 COR SEC 5. PLACED PK SHORT TIES
- 1976 BARNES VOL 5 PG 205 SHOWS FENCE LINES FROM LINE BETWEEN S 1/4 COR SEC 32 TO S 1/4 COR SEC 33.
- 1977 BARNES VOL 5 PG 265 SET ALUM. MON @ S 1/4 COR SEC 32
- 1978 COMBS CSM VOL B PG 137 FD PIPE @ N 1/4 COR SEC 5 CENTER TWP

SHEET 1 OF 3
CORNER CODE Z-7

Desel Bornes 3-26-2009

PO624	S1/4SEC 32
1978	PHILLIPSON CSM VOL 8 PG 258 STATES NOTHING ABOUT
	MON.
1983	BARNES VOL 6 PG 305 FD ALUM WHICH IS EAST OF FD 2" PIPE.
1983	COMBS CSM VOL 11 PG 305 ALUM @ N 1/4 COR SEC 5
1900	
	CENTER TWP
1983	COMBS CSM VOL 11 PG 307 ALUM @ N 1/4 COR SEC 5
	CENTER TWP
1983	COMBS #532 CENTER TWP FD PIPE @ N 1/4 COR SEC 5
	CENTER TWP
1988	COMBS CSM VOL 13 PG 378 FD ALUM @ N 1/4 COR SEC 5
	CENTER TWP. 5012.27 TO ALUM @ S 1/4 COR SEC 5
1992	KARNS #10033 ALUM, MON.
1993	KARNS CSM VOL 16 PG 268 ROCK COUNTY MON 5323.34
	TO N 1/4 COR SEC 32
1994	KARNS CSM VOL 17 PG 245 ROCK COUNTY MON. 5323.17
•	TO S 1/4 COR SEC 32.
1994	KARNS CSM VOL 17 PG 246 ROCK COUNTY MON
1997	KARNS #8480 FD ALUM MON.

FD 1" PIPE 0.1' DEEP; 1.5' WEST OF CEN OF PVMT. & REC SE REFERENCE MONUMENT. DID NOT FIND OTHER REF. MONUMENTS.

C) Was the corner restored through acceptance of (1) an obliterated evidence location, or, (2) a found perpetuated location?

ACCEPTED PERPETUATED LOCATION.

D) Describe any material discrepancy between the location of the corner as restored or reestablished and the location of that corner as previously restored or reestablished by distance and direction. Show the discrepancy on the plan view drawing under (a), above. Show the distances between the corner as previously restored or reestablished and (1) the corner as restored or reestablished, and (2) to at least 4 of the witness monuments shown on the drawing in (a), above.  $\mathbb{N} \square$ 

(E) Was the corner reestablished through lost corner proportionate methods? If so, show the method, including the directions and distances to other public land survey corners used as evidence or used for proportioning the corner location.

I, **Donald Barnes**, hereby certify that the corner location as identified by the corner code index was determined by me under my direction and control and that this U.S. Public Land Survey Monument Record is correct and complete to the best of my knowledge and belief.

SHEET 2 OF 3

3-7.6-2009

corner code Z-7

A.E. 7.08 REQUIREMENT

