Paper weight-110# (minimum)

Black nonfading ink required


## LAND U.S. **PUBLIC** SURVEY MONUMENT

For Public Land Survey Corners In:

WI ADMINISTRATIVE CODE A-E 7.08 REQUIREMENT

T. 4 N. R. 11 E. 4th P.M.

CORNER CODE INDEX

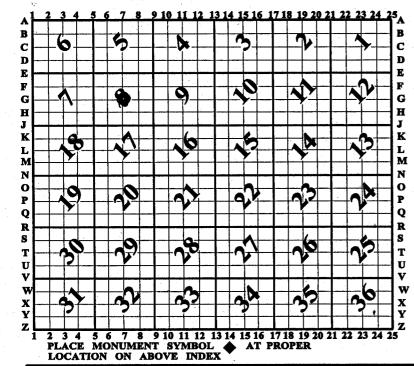

## **PORTER** TWP **ROCK COUNTY WI**

IF AVAILABLE ROCK COUNTY COORDINATES PERFERRED

North	Elev.				
East					
Hor. Datum	Vert. Datum				
LATITUDE _		ELLIPS. HT.			
LONGITUDE					
NAD83(91)	NETWORK ADJ. YR				
GPS (X)	TRAVERSE (X)				
BASED ON TH	E FOLLOWING CO	NTROL:			

**◆ CORNER MONUMENT** 

WITNESS MONUMENT

BEARINGS ARE BASED ON:

.(a)

			,	1 1	1
FIELD BOOK	PAGE #			SHEET	$\_$ of $\angle$
SHOW A PLAN VIEW DE	RAWING DEPICTIN	G THE CORNER MON	NUMENT AND S	SURROUNDI	NG <sup>'</sup>
PHYSICAL FEATURES,	INCLUDING THE E	XCAVATION AREA A	ND DEPTH.		
PLANNING & ZONING	COMMITTEE ADOPT	ED THIS FORM ON 12/2/1	1982		

## P04535 **CENTERSECS**

- (B) Describe any record evidence, monument evidence, occupational evidence, testimonial evidence or any other material evidence you considered, and whether the monument was found or placed.
- RUGER VOL 2 PG 25 SET HH STONE 15X9X7 & 1870 SURROUNDELD IT BY 4 HARD HEAD STONES. EASTERLY 1348.38 TO SET IRREGULAR HH STONE 18X8X7 POINT UP @ 1/16TH COR, EASTERLY 1348.38 TO FD OLD STAKE & ALSO FD BEARING TREES-SET HH STONE 9X4X3 @ E1/4 COR SEC B. [MAP INDICATES HE EST CENTER @ INTERSECTION OF 1/4 LINES.
- SURVEYOR UNKNOWN BARNES VOL 6 PG 320 FIELD BOOK 1892 B2 PG 116 DATED APR 30 1892 CALLS FOR CENTER OF SEC B AS GONE.
- COMBS CSM VOL 11 PG 620 SET R/R SPIKE 1984 ANGLE 89-49-10 @ CEN FROM S 1/4 COR SEC 8 TO W 1/4 COR SEC 8, WESTERLY 33.00 TO PIPE @ PROPERTY COR., & 2657.09 TO ALUM @ S 1/4 COR SEC 8. CALLS FOR STONE @ W 1/4 COR SEC 8, ALUM @ E 1/4 COR SEC 8, & FD RR @ N 1/4 COR SEC 8.
- 1995 SCHROEDER CSM VOL 18 PG 437 ANGLE 90-10-50 @ CEN FROM W 1/4 COR SEC 8 TO N 1/4 COR SEC 8

FD R/R SPIKE D.1' DEEP. IT IS 0.46' SOUTH OF E/W 1/4 LINE & IS 2691.94 [RUGER 2696.76] TO E 1/4 COR SEC 8. 2657.04 [2657.09 COMBS] TO S 1/4 COR SEC 8. ANGLE 89-48-51 [89-49-10 COMBS] @ CEN FROM S 1/4 COR SEC 8 TO W 1/4 COR SEC 8

C) Was the corner restored through acceptance of (1) an obliterated evidence location, or, (2) a found perpetuated location?

DID NOT REJECT NOR ACCEPT R/R. THE 1870 RUGER HH STONE 15X9X7 & SURROUNDELD BY 4 HARD HEAD STONES SHOULD STILL BE IN. COMPUTATIONS INDICATE THE R/R SHOULD BE CLOSE.

- D) Describe any material discrepancy between the location of the corner as restored or reestablished and the location of that corner as previously restored or reestablished by distance and direction. Show the discrepancy on the plan view drawing under (a), above. Show the distances between the corner as previously restored or reestablished and (1) the corner as restored or reestablished, and (2) to at least 4 of the witness monuments shown on the drawing in (a), above.
- (E) Was the corner reestablished through lost corner proportionate methods? If so, show the method, including the directions and distances to other public land survey corners used as evidence or used for proportioning the corner location.

I, DONALD BARNES, hereby certify that the corner location as identified by the corner code index was determined by me under my direction and control and that this U.S. Public Land Survey Monument Record is correct and complete to the best of my knowledge and belief.

SHEET 1 OF 1

CORNER CODE G-7