Paper weight-110# (minimum)

Black nonfading ink required

LAND U.S. **PUBLIC** SURVEY MONUMENT RECORD


For Public Land Survey Corners In:

WI ADMINISTRATIVE CODE A-E 7.08 REQUIREMENT

REV 10/23/2004 USMONREC.DWG

T. $\frac{4}{1}$ N. R. $\frac{11}{1}$ E. 4th P.M.

CORNER CODE INDEX

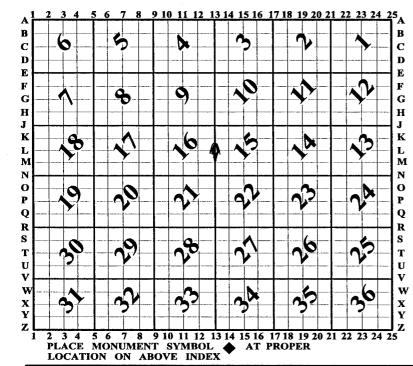

PORTER TWP **ROCK COUNTY WI**

IF AVAILABLE ROCK COUNTY COORDINATES PERFERRED

North Elev. East Hor. Datum _____ Vert. Datum LATITUDE ELLIPS. HT. LONGITUDE _ NAD83(91) NETWORK ADJ. YR GPS (X) ___ TRAVERSE (X) BASED ON THE FOLLOWING CONTROL:

◆ CORNER MONUMENT

O WITNESS MONUMENT

BEARINGS ARE BASED ON:

(a)

FIELD BOOK PAGE # SHOW A PLAN VIEW DRAWING DEPICTING THE CORNER MONUMENT AND SURROUNDING PHYSICAL FEATURES, INCLUDING THE EXCAVATION AREA AND DEPTH. PLANNING & ZONING COMMITTEE ADOPTED THIS FORM ON 12/2/1982

PO557 E-1/4-COR-SEC16

(B) Describe any record evidence, monument evidence, occupational evidence, testimonial evidence or any other material evidence you considered, and whether the monument was found or placed.

1833 HARRISON (NOV2) TAN RIIE 4TH MER. NORTH

BET. 15 & 16

2640.0 QUARTER SEC CORNER SET A POST & RAISED MOUND OF EARTH & SOD

5280.0 SET CORNER TO SECS 9,10,15,16

MARKED A POST AND RAISED AMOUND OF
EARTH & SOD LAND ROLLING 1ST RATE
PRAIRIE GROWTH GRASS & WEEDS

- 1851 STEBBINS PORTER TWP ROAD REC BK#1 PG 4 BEGINNING AT A POINT ON THE HIGHWAY LEADING WEST FROM VAN PATTENS BRIDGE ACROSS SEC 10 & 8(9?), WHERE THE LINE WHICH DIVIDES THE NW 1/4 OF THE SEC 10 RUNNING NORTH AND SOUTH INTERSECTS SAID HIGHWAY; THENCE SOUTH ON SAID LINE 11,503.14 TO THE 1/4 LINE RUNNING EAST & WEST, THROUGH SEC 22 T4NR11E AND THE WHOLE LENGTH OF THE RD IS 11,501.82. COURSES GIVEN ACCORDING TO THE TRUE MERIDIAN. VARATION OF NEEDLE 7 3/4 HARRISON STEBBINS, SURVEYOR
- PORTER TWP RD REC BK 1 PG 12 BEGINNING AT A POINT ON 1858 THE SECTION LINE BETWEEN SECTIONS 21 & 22 1438.80 SOUTH OF THE NE COR OF SEC 21 AT THE TERMINATION OF A ROAD CONTINUING SOUTH AND AT THE INTERSECTION OF A ROAD RUNNING NORTH WESTERLY THROUGH SECTIONS 21 & 22, THENCE NORTH ON THE SEC LINE BETWEEN SECTIONS 21 & 22, 15 & 16, 9 & 10, 11,998.8 TO THE NE COR OF SEC 9. ALSO BEGINNING AT THE NE COR OF THE WEST 1/2 OF THE NW 1/4 OF SEC 15; THENCE WEST ON THE SEC LINE BETWEEN SECTIONS 10 & 15, 9 & 16, 6,600' TO THE SW COR OF SEC 9 AND THE LINES ABOVE DESCRIBED ARE THE CENTER OF HIGHWAYS 66' WIDE AND WE THE SAID SUPERVISORS DO HEREBY DISCONTINUE THE PUBLIC HIGHWAY DISCRIBED AS FOLLOWS: BEGINNING AT THE SE COR OF THE W 1/4 OF SEC 22 AND RUNNING NORTH ON THE LINE OF EIGHTIES THROUGH SAID QUARTER SECTION AND THROUGH SEC 15 AND A PORTION OF SEC 10, UNTIL IT INTERSECTS THE ROAD RUNNING WEST FROM VAN TATTENS BRIDGE THROUGH SEC 10,
- 1968 BATTERMAN VOL 4 PG 367 FD HH SURROUNDED BY 4 HH
 1.5 DEEP. REFERENCED SAME. ON LINE E/W FENCE LINES
 IN CASEY RD
- 1994 SHROEDER CSM VOL17 PG 431 STATES NOTHING ABOUT MON. SO-45W TO SW COR SEC 15.

REFERENCE PIPES ON EAST SIDE WERE IN HEAVY UNDERGROWTH. AREA APPEARED TO HAVE BEEN DISTURBED & OLD N/S FENCE LINE WAS REPLACED. SW REFERENCE PIPE APPEARS TO BE AT NATURAL GRADE AND NW REFERENCE PIPE WAS FILLED.

SHEET 1 OF 3 CORNER CODE L-13

Ondel Barnes 3-17.2009

PO557 E-1/4-COR-SEC16

C) Was the corner restored through acceptance of (1) an obliterated evidence location, or, (2) a found perpetuated location?

ACCEPTED FD REFERENCE PIPES. USED TO PERPETUATE CORNER DID NOT FIND ANYTHING AT THE PVMT SURFACE.

D) Describe any material discrepancy between the location of the corner as restored or reestablished and the location of that corner as previously restored or reestablished by distance and direction. Show the discrepancy on the plan view drawing under (a), above. Show the distances between the corner as previously restored or reestablished and (1) the corner as restored or reestablished, and (2) to at least 4 of the witness monuments shown on the drawing in (a), above.

NDNE

(E) Was the corner reestablished through lost corner proportionate methods? If so, show the method, including the directions and distances to other public land survey corners used as evidence or used for proportioning the corner location.

NΟ

I, **Donald Barnes**, hereby certify that the corner location as identified by the corner code index was determined by me under my direction and control and that this U.S. Public Land Survey Monument Record is correct and complete to the best of my knowledge and belief.

SHEET 2 OF 3

CORNER CODE L-13

A.E. 7.08 REQUIREMENT

