Paper weight-110# (minimum)

Black nonfading ink required

## U.S. PUBLIC LAND SURVEY MONUMENT RECORD


For Public Land Survey Corners In:

WI ADMINISTRATIVE CODE A-E 7.08 REQUIREMENT

IEV 10/23/2004 USMONREC.DWG

T. 4 N. R. 11 E. 4th P.M.

CORNER CODE INDEX

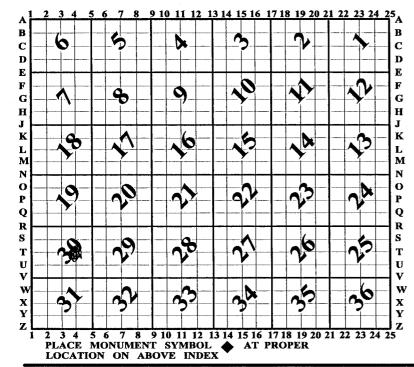

PORTER TWP

IF AVAILABLE ROCK COUNTY COORDINATES PERFERRED

North	Elev.
East	
Hor. Datum	Vert. Datum
LATITUDE	ELLIPS. HT.
LONGITUDE	
NAD83(91)	_NETWORK ADJ. YR
GPS (X)	TRAVERSE (X)
BASED ON THE	FOLLOWING CONTROL:

**◆ CORNER MONUMENT** 

O WITNESS MONUMENT

BEARINGS ARE BASED ON:

(a)

FIELD BOOK PAGE # SHOW A PLAN VIEW DRAWING DEPICTING THE CORNER MONUMENT AND S	SHEET SURROUN	 OF	<u>Z</u>
PHYSICAL FEATURES, INCLUDING THE EXCAVATION AREA AND DEPTH.			
PLANNING & ZONING COMMITTEE ADOPTED THIS FORM ON 12/2/1982		 	/)

## PO2594 N1/16HCOR-SE1/4-SEC30

- (B) Describe any record evidence, monument evidence, occupational evidence, testimonial evidence or any other material evidence you considered, and whether the monument was found or placed.
- 1874 RUGER VOL 2 PG 179 VAR 7-35 1327.26 TO E 1/4 COR SEC 30, VAR 7-35 1327.26 TO CEN OF SEC 30, & VAR 7-35 3891.14 TO W 1/4 COR SEC 30
- 1971 LEE VOL 4 PG 493 FD 2 HH & REFERENCED SAME. SHORT PK REFERENCE TIES B' NE & B' NW.

FD PK 0.1' DEEP, BENT NW REFERENCE PIPE & NE REFERENCE PK 0.1' BELOW PVMT. FD PK IS 2' NORTH OF CEN OF PVMT.

C) Was the corner restored through acceptance of (1) an obliterated evidence location, or, (2) a found perpetuated location?

## ACCEPTED OBLITERATED LOCATION

D) Describe any material discrepancy between the location of the corner as restored or reestablished and the location of that corner as previously restored or reestablished by distance and direction. Show the discrepancy on the plan view drawing under (a), above. Show the distances between the corner as previously restored or reestablished and (1) the corner as restored or reestablished, and (2) to at least 4 of the witness monuments shown on the drawing in (a), above.

NONE

(E) Was the corner reestablished through lost corner proportionate methods? If so, show the method, including the directions and distances to other public land survey corners used as evidence or used for proportioning the corner location.

 $N\Box$ 

I, DONALD BARNES, hereby certify that the corner location as identified by the corner code index was determined by me under my direction and control and that this U.S. Public Land Survey Monument Record is correct and complete to the best of my knowledge and belief.

SHEET 1 OF 2

Embors Barnes 3-18-2009

CORNER CODE T-4

A.E. 7.08 REQUIREMENT

