

Paper weight-110# (minimum)

Black nonfading ink required

# U.S. PUBLIC LAND SURVEY MONUMENT RECORD

For Public Land Survey Corners In:

WI ADMINISTRATIVE CODE A-E 7.08 REQUIREMENT

T. 4 N. R. 11 E. 4th P.M.

REV 10/23/2004

USMONREC.DWG

CORNER CODE INDEX

PORTER TWP

ROCK COUNTY WI

IF AVAILABLE

ROCK COUNTY COORDINATES PREFERRED

	1	2	3	4	5	6	7	8	9	10	11	12	13	14	15	16	17	18	19	20	21	22	23	24	25		
A																											A
B																											B
C																											C
D																											D
E																											E
F																											F
G																											G
H																											H
J																											J
K																											K
L																											L
M																											M
N																											N
O																											O
P																											P
Q																											Q
R																											R
S																											S
T																											T
U																											U
V																											V
W																											W
X																											X
Y																											Y
Z																											Z

North \_\_\_\_\_ Elev. \_\_\_\_\_

East \_\_\_\_\_

Hor. Datum \_\_\_\_\_ Vert. Datum \_\_\_\_\_

LATITUDE \_\_\_\_\_ ELLIPS. HT. \_\_\_\_\_

LONGITUDE \_\_\_\_\_

NAD83(91) \_\_\_\_\_ NETWORK ADJ. YR \_\_\_\_\_

GPS (X) \_\_\_\_\_ TRAVERSE (X) \_\_\_\_\_

BASED ON THE FOLLOWING CONTROL:

PLACE MONUMENT SYMBOL  AT PROPER LOCATION ON ABOVE INDEX

CORNER MONUMENT

WITNESS MONUMENT

(a)

BEARINGS ARE BASED ON: -----

FIELD BOOK \_\_\_\_\_ PAGE # \_\_\_\_\_

SHEET 1 OF 3

SHOW A PLAN VIEW DRAWING DEPICTING THE CORNER MONUMENT AND SURROUNDING PHYSICAL FEATURES, INCLUDING THE EXCAVATION AREA AND DEPTH.

PLANNING & ZONING COMMITTEE ADOPTED THIS FORM ON 12/2/1982

CORNER CODE N-21

P0571

SECORSEC14

(B) Describe any record evidence, monument evidence, occupational evidence, testimonial evidence or any other material evidence you considered, and whether the monument was found or placed.

1833 HARRISON (OCT 29TH) T4N R11E 4TH MER. NORTH  
BET. 23 & 24

2640.0 QUARTER SEC COR.  
SET A POST & RAISED A MOUND OF EARTH & SOD

2838.0 ROAD FROM THE MOUTH OF CATFISH TO DOUGHERTY'S FURNANCE SUGAR CREEK CRS E & W

4543.44 BURR OAK 18 IN DIAM AND LEVEL PRAIRIE

5280.0 SET COR TO SECS 13,14,23, 24 {BURR OAK 18 S25W 31.68' BURR OAK 10 S25E 34.32'; BURR OAK 20 N25W 141.90'; WHITE OAK 15 N69E 69.30' LAND THE 1<sup>ST</sup> 4,488' IS HANDSOME ROLLING PRAIRIE - SOIL 1<sup>ST</sup> RATE- REMAINDER ROLLING 2<sup>ND</sup> RATE WITH BURR & WHITE OAK TIMBER.

1833 (OCT 29 NOV 4) HARRISON EAST ON RAND BET SECS 13 & 24

T4N R11E 4TH MER

144.54 CATFISH CRK RIGHT BANK SET GUIDE POST CRS S.E.

290.4 LEAVE CAT FISH SET MEANDER GUIDE POST ON LEFT BANK

2640 TEMPY 1/4 SEC COR

3019.5 TRAIL NORTH

3321.78 NORTHERN BEND OF CATFISH SET G.P

4224 LEAVE CAT FISH SET G.P. CRS SE

4504.5 CAT-FISH CRS NE SET GUIDE P

4711.08 LEAVE CAT-FISH SET GUIDE P

5313 INT. E BDY 3.3?(330'?) N OF P LAND ROLLING 2<sup>ND</sup> RATE WITH RED BURR & WO TIMBER

COR. WEST BET SECS 13 & 24

601.92 SET M.P. ON RIGHT BANK OF CATFISH RED O 10 S41E 75.9'

808.5 LEAVE CATFISH SET MEAN. P RED O 12 N45W 405.9'?

1089 BEND OF CAT-FISH SET MEAN. P. BURR O 10 NORTH 264'

1993.2 LEAVE CAT-FISH SET MEAN P. RED O 12 N33E 39.6'?

2656.5 QUARTER SEC COR {W.O. 10 S42E 479.82' W.O. 12 S80W 29.04'

5022.6 LEFT BANK OF CAT-FISH SET MEAN P. W.O.

5168.46 LEAVE CATFISH SET MEAN. P. WO. 15 N82W 77.88' BURR O 20 S3E 77.88'

5313 SEC COR.

1833 HARRISON (OCT 29TH) T4N R11E 4TH MER. NORTH  
BET. 13 & 14

346.50 CAT-FISH CREEK CR S.E. SET MEANDER POST BURR OAK 10 S10W 55.44'; BURR OAK 18 N77W 15.84'

570.90 LEAVE CAT-FISH SET MEANDER POST {RED OAK 12 S75E 134.64'

1307.46 CAT-FISH CRS S.W. SET MEANDER POST {RED OAK 12 S25E 77.22'

1534.50 LEAVE CAT-FISH & SET MEANDER POST {BURR OAK 12 N15E 66.66'; BURR OAK 12 N60W 43.56'

*Donald Fawcett*  
12/01/09

PO571 SECORSEC14

2640.0 SET POST FOR COR TO QUARTER SEC  
{BURR OAK 12 S25W 35.64'; BURR OAK  
18 N10W 43.56'  
2854.50 CAT-FISH CRS S.E. SET MEANDER POST  
{BURR OAK 18 S22E 29.70'; BURR OAK  
20 NB1W 30.36'  
3127.08 LEAVE CAT-FISH SET MEANDER POST  
{BURR OAK 12 N70E 18.48'; BURR OAK 8  
N19W 33.66'  
3678.18 TO A BROOK 6.6' CRS S.W  
4654.98 ENTER PRAIRIE  
5280.0 SET POST & RAISED MOUND FOR COR TO  
SECS 11,12,13,14 LAND ROLLING 2<sup>ND</sup>  
RATE TIMBER ??? BURR OAK  
UNDERGROWTH HAZEL, ??, GRASS

1833 HARRISON (NOV)

T4N R11E 4<sup>TH</sup> MER. EAST  
BET. 14 & 23

2640.0 TEMPY 1/4 SEC COR  
4620.0 LEFT PRAIRIE & ENTER TIMBER  
5324.88 INT. EAST BDY 7.92' SOUTH OF POST  
LAND 1<sup>BT</sup> RATE ROLLING PRAIRIE GROWTH  
GRASS & WEEDS

WEST COR WEST

2662.44 QUARTER SEC COR SET A POST AND  
RAISED A MOUND

5324.88 SEC COR

1885 RUGER VOL 2 PG 293 FD S.W. & NW BETS & STUMP OF SE BT  
DROVE STAKE & SURROUNDED BY 4 HH. 2649.90 TO E 1/4  
COR SEC 23, SET HH 14X8X6 @ E 1/16TH COR OF NE 1/4  
SEC 23, DROVE STAKE & PUT HH STONE ON N & S SIDES  
OF N 1/16TH COR OF NE 1/4 SEC 23, 5448.96 TO NW COR  
SEC 23.

1958 BATTERMAN JR. VOL 3 PG 567 SHOWS ON DRAWING BUT  
STATES NOTHING ABOUT IT OR ANY DISTANCES

1977 WPL #3592 & 3625 DUG AT OCCUPATION & FD NOTHING

1977 BARNES VOL 5 PG 253 FB#1 PG 47 DUG & FD NOTHING.  
SET AT RECORD DISTANCE (RUGER) FROM E 1/4 COR SEC 23  
AND ON LINE WITH E 1/4 COR SEC 23 & FENCE  
INTERSECTION AT THE E 1/16TH COR OF THE NE 1/4 OF SEC  
23. SET ALUM. MON. REFERENCED SAME. CORNER IS 5'  
NORTH OF E/W FENCE & 7 EAST OF N/S FENCE

1977 BARNES VOL 5 PG 255 I TRAVERSED SEC 23. RESULTS  
INDICATE RUGER DIVIDED THE SECTION BY INTERSECTING  
THE E/W 1/4 INE AND THE N/S 1/4 LINE. BATTERMAN JR.  
AGREED THAT THE SW COR OF THE NE 1/4 OF THE NE 1/4  
AND THE NW COR OF THE NE 1/4 OF THE NE 1/4 WERE  
ERRONEOUSLY FOUND. THE HIGHWAY RECORDS, THE S  
1/16TH COR OF THE NE 1/4, THE OCCUPATION LINE, ANT  
THE CORNER'S LOCATION TO THE N 1/4 COR AND THE NE  
COR INDICATE THE N 1/6 COR SHOULD BE SET ON PG VOL 5  
PG 254. THE NE COR WAS SET BY PROJECTING THE E 1/4  
COR AND THE FENCE INTERSECTION AT THE E 1/16 COR OF  
THE NE 1/4 AT RECORD DISTANCE. THIS POINT AGREED  
WITH THE RECORD DISTANCE TO THE OCCUPATION TO THE  
NW CORNER. 1362.24 TO N 1/16 OF NE 1/4 OF SEC 23,  
2724.48 TO N 1/4 COR SEC 23, 5448.95 TO NW COR SEC  
23, S1-16-15W 2649.90 TO E 1/4 COR SEC 23.

1977 BARNES VOL 6 PG 398 ANGLE 88-59-44 @ NE COR SEC 23  
FROM E 1/4 TO N 1/4 COR SEC 23, S00-53-16W 2649.82 TO  
E 1/4 COR SEC 23, S89-52-56W 2724.45 TO N 1/4 COR SEC  
23, S89-52-56W 1362.23 TO 1/16TH COR.

SHEET 2 OF 3

CORNER CODE N-21

Donald Barnes  
12/01/09

PO571 SECORSEC14

1977 COMBS CSM VOL 6 PG 280 FD ALUM. WESTERLY 1361.96 TO  
FD IP @ NW COR OF NE 1/4 OF NE 1/4 OF SEC 23, WHICH IS  
ON THE WEST SIDE OF THE RD R/W

1992 SCHROEDER CSM VOL 15 PG 395 STATES NOTHING ABOUT  
MON. WESTERLY 1331.81 TO PT ON SEC LINE.

I USED MY 1978 OBSERVATIONS

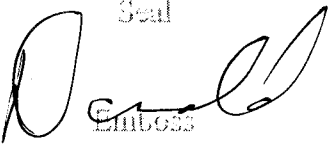
C) Was the corner restored through acceptance of (1) an obliterated evidence location, or, (2) a found perpetuated location?

**ACCEPTED ALUM. MON. & TIES OF RECORD.**

D) Describe any material discrepancy between the location of the corner as restored or reestablished and the location of that corner as previously restored or reestablished by distance and direction. Show the discrepancy on the plan view drawing under (a), above. Show the distances between the corner as previously restored or reestablished and (1) the corner as restored or reestablished, and (2) to at least 4 of the witness monuments shown on the drawing in (a), above.

(E) Was the corner reestablished through lost corner proportionate methods? If so, show the method, including the directions and distances to other public land survey corners used as evidence or used for proportioning the corner location.

I, **Donald Barnes**, hereby certify that the corner location as identified by the corner code index was determined by me under my direction and control and that this U.S. Public Land Survey Monument Record is correct and complete to the best of my knowledge and belief.

Seal  
  
Emboss  
Barnes  
12/01/09

SHEET 3 OF 3

CORNER CODE **N-21**

**A.E. 7.08 REQUIREMENT**