

U.S. PUBLIC LAND SURVEY MONUMENT RECORD


For Public Land Survey Corners in the
T. 4 N., R. 11 E.

CORNER CODE INDEX

	1	2	3	4	5	6	7	8	9	10	11	12	13	14	15	16	17	18	19	20	21	22	23	24	25
A																									
B																									
C	6																								
D		5																							
E			4																						
F				3																					
G					2																				
H	7																								
I		6																							
J			5																						
K				4																					
L					3																				
M						2																			
N							1																		
O																									
P	9																								
Q		20																							
R			21																						
S				22																					
T					23																				
U						24																			
V																									
W																									
X	31																								
Y		32																							
Z			33																						
				34																					
					35																				
						36																			

PLACE MONUMENT SYMBOL (◊) AT PROPER LOCATION ON ABOVE INDEX

EXAMPLE

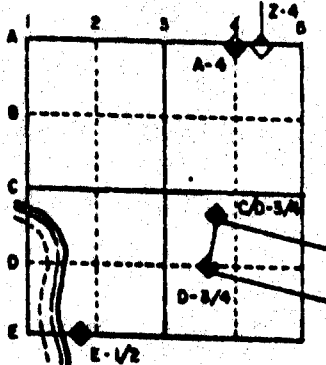

PORTER TWP
ROCK COUNTY WI


IF AVAILABLE STATE PLANE COORDINATES

North (Y) _____ Elev. (Z) _____
 East (X) _____ Zone _____
 Hor. Datum _____ Vert. Datum _____

◊ CORNER MONUMENT

○ WITNESS MONUMENT

BEARINGS ARE BASED ON: ASSUMED

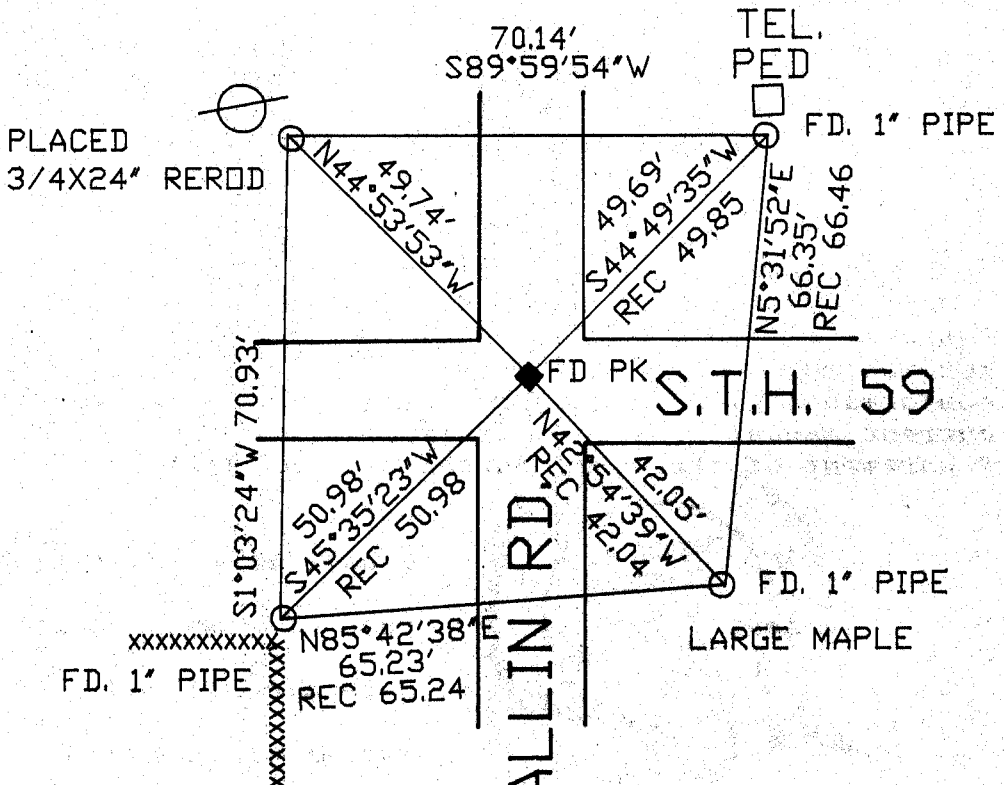

FIELD BOOK #3 PG 28
 FOUND SW PK 10.93 (REC 10.91)
 FOUND SE PK- 9.50 (REC 9.49)
 CORNER IS 1.8' NORTH OF CENTER OF PAVEMENT &
 3' EAST OF CENTER OF PAVEMENT THAT IS TO THE NORTH.
 OLD TIES- VOL 4 G 223

MICROFILMED

SHEET ___ OF ___

CORNER CODE: 621

(B) Describe any record evidence, monument evidence, occupational evidence, testimonial evidence or any other material evidence you considered, and whether the monument was found or placed.

1833 HARRISON ORIGINAL SURVEY. PLACED A POST AND RAISED A MOUND OF EARTH OF SOD FOR THE CORNER. SHOWS 2640 TO THE NORTHEAST AND SOUTHEAST CORNERS OF SECTION 11.

1871 RUGER VOL 2 PG 63 FOUND LIMESTONE & 2 OLD STAKES UNDER IT, ONE VERY MUCH DECAYED, DROVE NEW STAKE DEEP & PUT LIMESTONE ON TOP OF IT 1'6X7X6 SURROUNDED IT WITH 4 LIMESTONES. USED TO SUBDIVIDE SECTION 12. SHOWS 1322.06 TO THE S 1/16TH CORNER OF THE NW QUARTER OF SECTION 12.

1886 RUGER VOL 2 PG 282 FOUND CORNER AS SET BY SELF. USED TO SUBDIVIDE SECTION 11. SHOWS 2743.95 TO THE CENTER OF SECTION 11, 2578.84 TO THE NE CORNER OF SECTION 11; AND 2753.52 TO THE SE CORNER OF SECTION 11. SHOWS A BEND IN THE SECTION LINE AT THE QUARTER CORNER.

1965 BATTERMAN JR. VOL 4 PG 223 SET 1" PIPE 3' DEEP WITH 1 L.S. & 4 L.S. SHOWS TIES FOR CORNER. STATES WORK WAS DONE BY SURVEYOR'S OF W.P. & L. CO.

FOUND PK AND REFERENCE PIPES.



C) Was the corner restored through acceptance of (1) an obliterated evidence location, or, (2) a found perpetuated location?

ACCEPTED FOUND PERPETUATED PK.

D) Describe any material discrepancy between the location of the corner as restored or reestablished and the location of that corner as previously restored or reestablished by distance and direction. Show the discrepancy on the plan view drawing under (a), above. Show the distances between the corner as previously restored or reestablished and (1) the corner as restored or reestablished, and (2) to at least 4 of the witness monuments shown on the drawing in (a), above.

(E) Was the corner reestablished through lost corner proportionate methods? If so, show the method, including the directions and distances to other public land survey corners used as evidence or used for proportioning the corner location.

I, Donald Barnes, hereby certify that the corner points as identified by the corner code index were, in a field survey on, February 12, 1991, established, re-established, monumented, re-monumented, recovered or restored as expressed below and in conformance with the regulations and rules as required in the current manual of survey instructions of the United States Department of the Interior Bureau of Land Management.

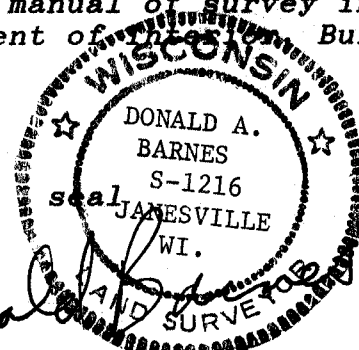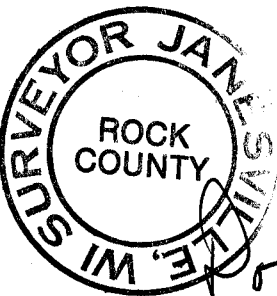

COUNTY SURVEYOR FILING DATA

Date of computer entry _____

Date microfilmed _____

Number of included sheets _____
CORNER CODE

AFFIX YOUR LAND SURVEYOR SEAL

621