



(B) Describe any record evidence, monument evidence, occupational evidence, testimonial evidence or any other material evidence you considered, and whether the monument was found or placed.

1833 HARRISON ORIG SURVEY.

1845 PEASE SMITH & BAILEY'S ADD. BK 1 PG 9. SHOWS THE CORNER ON THE EASTERLY RIGHT OF WAY LINE OF MADISON ST AND 130.68 FROM THE JACKSON ST.

1851 MILLER - HIELD'S ADD BK 2 PG 23,24 SUBDIVISION COMMENCES AT A POINT ON THE NORTH SIDE OF MADISON STREET JACKSON ST 345.18 WEST OF THE SECTION CORNER.

1852 MILLER COOLMAN'S SUB BK 2 PG 31. SHOWS THE CORNER IN THE CENTER OF CROFT ST AND ON LINE WITH THE EASTERLY RIGHT OF WAY OF MADISON STREET AND 114.18 NORTH OF THE NE CORNER OF JACKSON AND MADISON. SHOWS THE CORNER AS 33 FROM THE SOUTH RIGHT OF WAY LINE OF CROFT ST (NOW MINERAL POINT ROAD).

1858 RUGER - MITCHELL'S ADD BK 1 PG 7 SHOWS THE CORNER ON THE EASTERLY RIGHT OF WAY LINE OF MADISON ST AND 130.68 FROM THE NE CORNER OF JACKSON AND MADISON.

1879 RUGER ECHLIN'S ADD BK 4 PG 9. STATES THAT SE CORNER OF THE SUBDIVISION IS 66 WEST AND 33 NORTH OF THE SW CORNER OF SECTION 25. ALSO SHOWS THE NORTH RIGHT OF WAY FOR MINERAL POINT AS 33 FROM THE SECTION LINE.

ESTABLISHED CORNER BY INTERSECTING THE CENTER OF MINERAL POINT RIGHT OF WAY AND THE EASTERLY RIGHT OF WAY OF MADISON STREET. THIS IS IN HARMONY WITH THE NE INTERSECTION OF JACKSON AND MINERAL POINT.


C) Was the corner restored through acceptance of (1) an obliterated evidence location, or, (2) a found perpetuated location?

RESTORED CORNER THROUGH ACCEPTANCE OF OBLITERATED EVIDENCE LOCATION.

D) Describe any material discrepancy between the location of the corner as restored or reestablished and the location of that corner as previously restored or reestablished by distance and direction. Show the discrepancy on the plan view drawing under (a), above. Show the distances between the corner as previously restored or reestablished and (1) the corner as restored or reestablished, and (2) to at least 4 of the witness monuments shown on the drawing in (a), above.

(E) Was the corner reestablished through lost corner proportionate methods? If so, show the method, including the directions and distances to other public land survey corners used as evidence or used for proportioning the corner location.

I, Donald Barnes, hereby certify that the corner points as identified by the corner code index were, in a field survey on, JULY 11, 1991 established, re-established, monumented, re-monumented, recovered or restored as expressed below and in conformance with the regulations and rules as required in the current manual of survey instructions of the United States Department of Interior, Bureau of Land Management.

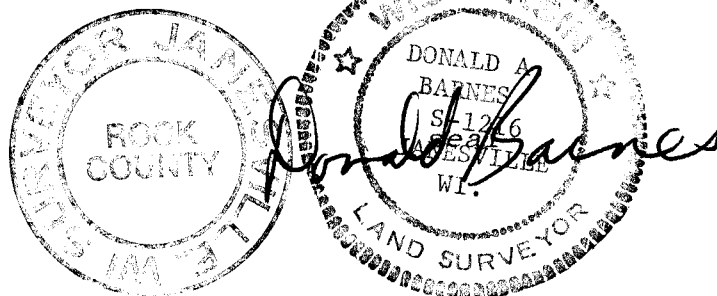

COUNTY SURVEYOR FILING DATA  
Date of computer entry \_\_\_\_\_  
Date microfilmed \_\_\_\_\_  
Number of included sheets \_\_\_\_\_  
CORNER CODE

AFFIX YOUR LAND SURVEYOR SEAL

V21

(b.) Describe any record evidence, monument evidence, occupational evidence, testimonial evidence or any other material evidence you considered, and whether the monument was found or placed.


1877 RUGER VOL 2 PG 63 NOTES A LIMESTONE.

(c.) Was the corner restored through acceptance of (1) an obliterated evidence location, or, (2) a found perpetuated location?

(d.) Describe any material discrepancy between the location of the corner as restored or reestablished and the location of that corner as previously restored or reestablished by distance and direction. Show the discrepancy on the plan view drawing under (a), above. Show the distances between the corner as previously restored or reestablished and (1) the corner as restored or reestablished, and (2) to at least 4 of the witness monuments shown on the drawing in (a), above.

(e.) Was the corner reestablished through lost corner proportionate methods? If so, show the method, including the directions and distances to other public land survey corners used as evidence or used for proportioning in determining the corner location.

I, \_\_\_\_\_, hereby certify that the corner points as identified by the corner code index were, in a field survey on \_\_\_\_\_, established, re-established, monumented, re-monumented, recovered or restored as expressed below and in conformance with the regulations and rules as required in the current manual of survey instructions of the United States Department of Interior, Bureau of Land Management.

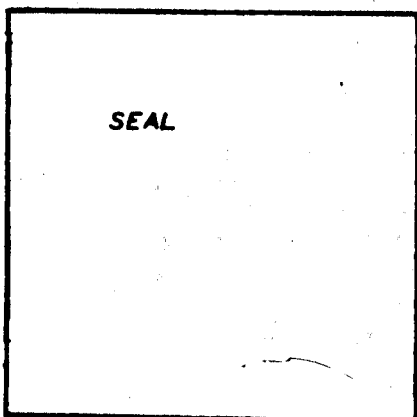

COUNTY SURVEYOR FILING DATA

Date of Computer Entry \_\_\_\_\_

Date Received \_\_\_\_\_

Date Microfilmed \_\_\_\_\_

Treasurer's Receipt No. \_\_\_\_\_

Number of Included Sheets \_\_\_\_\_

AFFIX YOUR LAND SURVEYOR SEAL. CORNER CODE V 21