

# U.S. PUBLIC LAND SURVEY MONUMENT RECORD

For Public Land Survey Corners in:

WI ADMINISTRATIVE CODE A-E 7.08 REQUIREMENT

T. 3 N., R. 12 E

### CORNER CODE INDEX

A	2	3	4	5	6	7	8	9	10	11	12	13	14	15	16	17	18	19	20	21	22	23	24	25
B																								
C	6																							
D		5																						
E			A																					
F				3																				
G					2																			
H	1																							
I		8																						
J			9																					
K				10																				
L					11																			
M						12																		
N							13																	
O								14																
P									15															
Q										16														
R											17													
S												18												
T													19											
U														20										
V															21									
W																22								
X																	23							
Y																		24						
Z																			25					

JANESVILLE TWP

ROCK COUNTY WI

IF AVAILABLE  
ROCK COUNTY COORDINATES PREFERRED

North 81,576.133m Elev. \_\_\_\_\_

East 680,819.272m

Hor. Datum NAD83 Vert. Datum \_\_\_\_\_

LATITUDE \_\_\_\_\_ ELLIPS. HT. \_\_\_\_\_

LONGITUDE \_\_\_\_\_

GPS (X) \_\_\_\_\_ TRAVERSE (X) \_\_\_\_\_

BASED ON THE FOLLOWING CONTROL:

PLACE MONUMENT SYMBOL  $\blacklozenge$  AT PROPER LOCATION ON ABOVE INDEX

$\blacklozenge$  CORNER MONUMENT

$\circ$  WITNESS MONUMENT


(a)

Poly.

NOTE ON PLAT: COORDINATES & BEARINGS ON THIS PLAT ARE ORIENTED TO THE WI COORDINATE SYSTEM SOUTH ZONE, NAD 83. ALL PLAT DISTANCES ARE GROUND LENGTH AND MAY BE CONVERTED TO GRID LENGTH BY MULTIPLYING THE DISTANCE BY THE GRID FACTOR PROVIDED ON THE DETAIL SHEETS.

WIDOT PROJ. #5569-03-21 DATE: MAY 19 1995

BEARINGS ARE BASED ON:

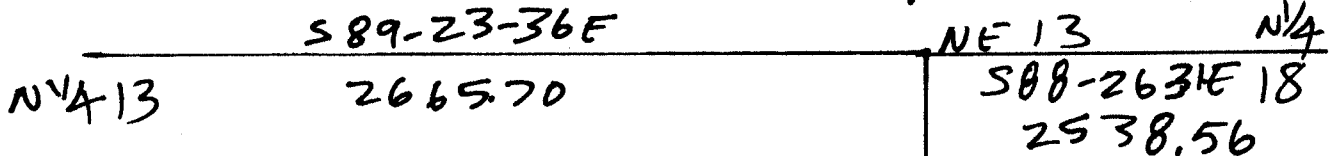

NAD 83  
267,637.70 FT  
2,233,654.56

D. Barnes  
4-04-04 286,302.04 FT COUNTY  
495,875.88

FIELD BOOK \_\_\_\_\_ PAGE # \_\_\_\_\_

SHEET 1 OF 1

SHOW A PLAN VIEW DRAWING DEPICTING THE CORNER MONUMENT AND SURROUNDING PHYSICAL FEATURES, INCLUDING THE EXCAVATION AREA AND DEPTH.

PLANNING & ZONING COMMITTEE ADOPTED THE ABOVE FORM ON 12/2/1982

CORNER CODE J-25