

# PLAT AND RECORD

Of a Survey on Section 20 T 3 R 13 E. of the 4 P. M. in Harmony Township


Rock County, Wisconsin, made April the 15 1890

I hereby certify that the following is a correct record of said survey as made by me.

COUNTY BUILDING  
IN CITY OF BELLOIT

(Signed) O. G. Bleedorn  
O.G.B.

Dept.  
County Surveyor.

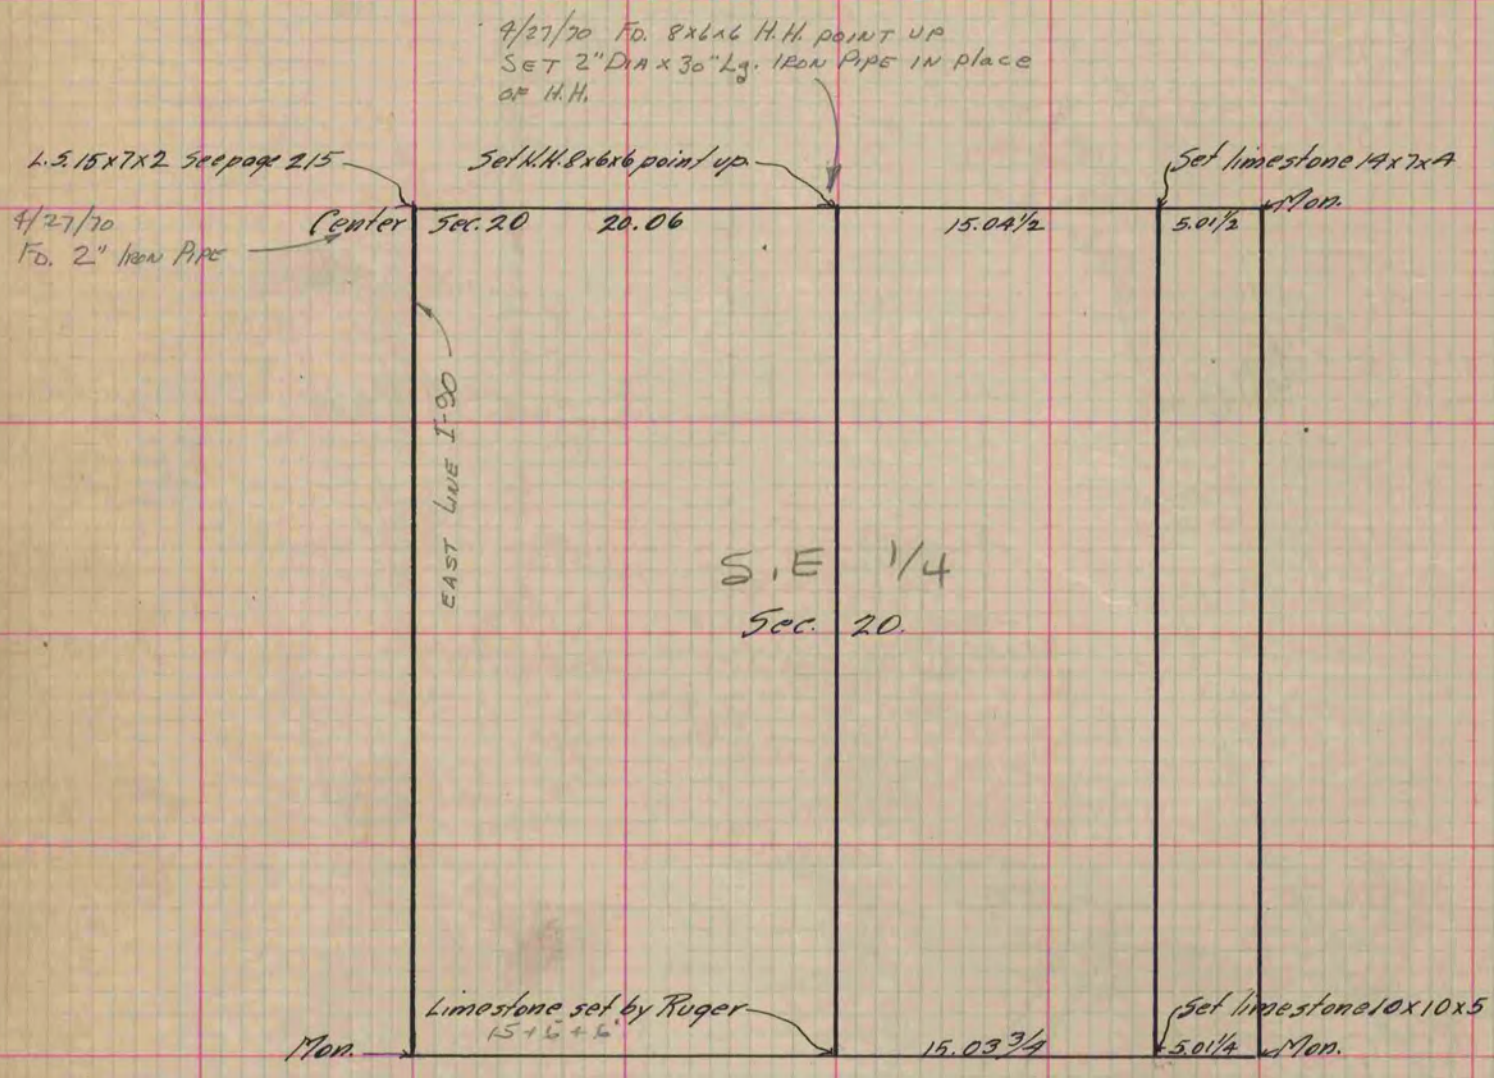

Copied from P. 345 Vol. 2 County Surveyor's Record.