

Of a Survey on Section 22 T 3 R 14 E. of the 4 P. M. in Johnstown Township


Rock County, Wisconsin, made June 20-1878 + January the 12 1884

I hereby certify that the following is a correct record of said survey as made by me.

COUNTY BUILDING  
IN CITY OF BELOIT

(Signed) Edward Roper  
R.R. 13

County Surveyor.

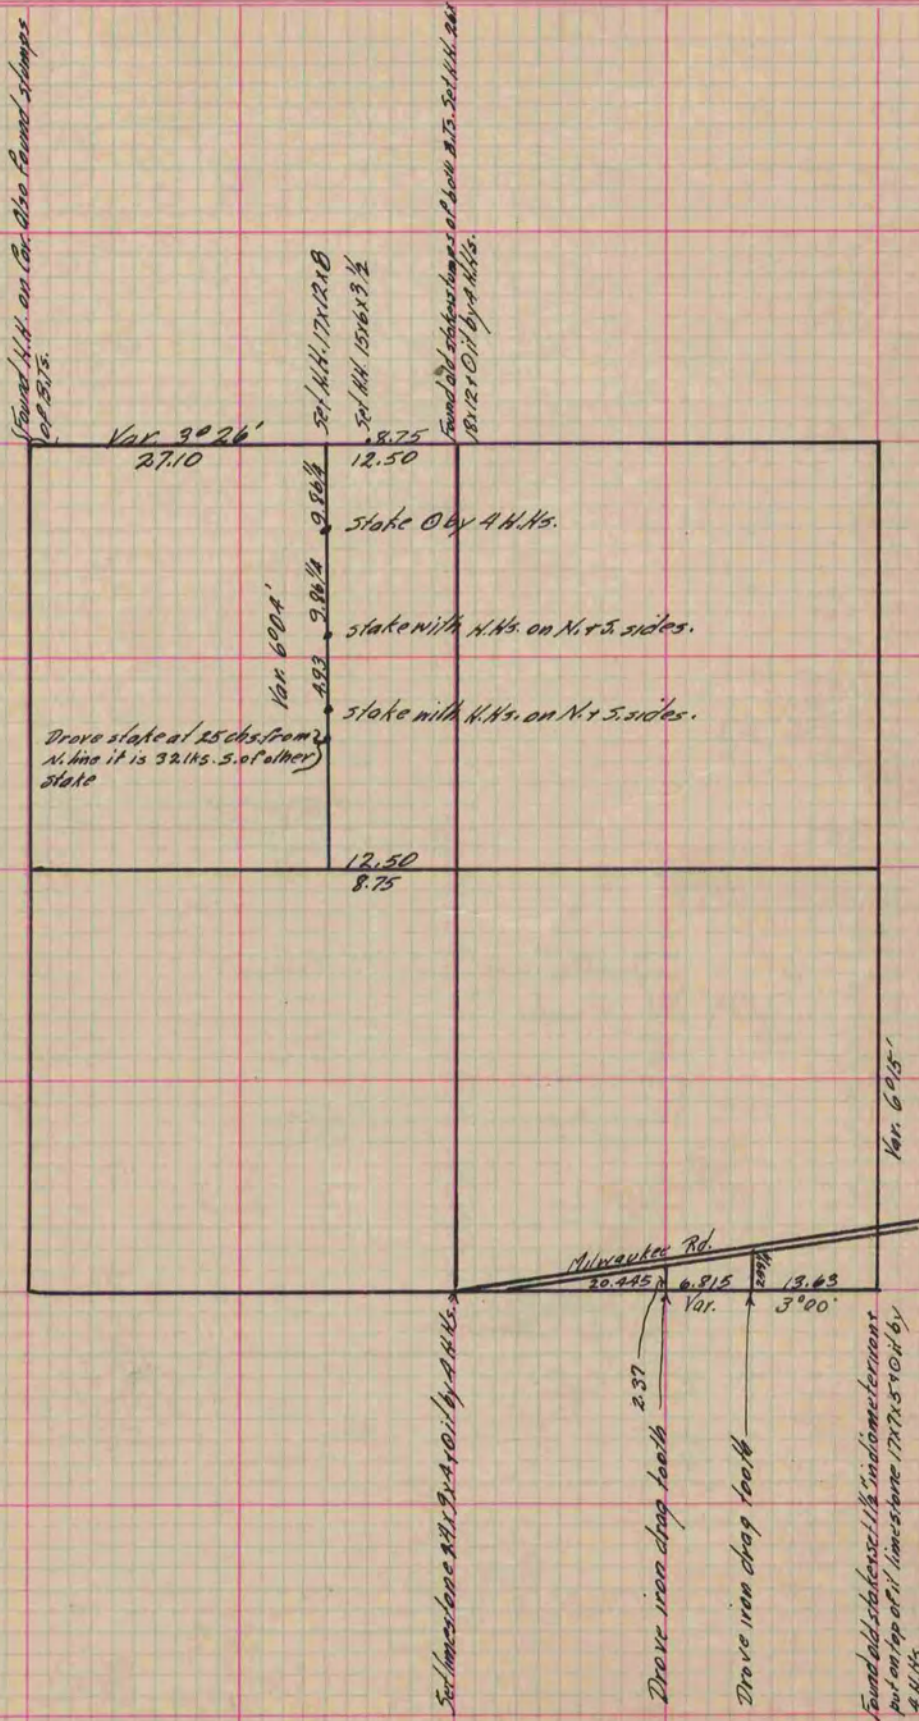

Copied from P. 208 Vol. 2 County Surveyor's Record.