

# PLAT AND RECORD


Of a Survey on Section 31 T 3 R 13 E. of the 4 P. M. in Harmony Township  
Rock County, Wisconsin, made Oct. the 15 1892

I hereby certify that the following is a correct record of said survey as made by me.

COUNTY BUILDING  
IN CITY OF БЕЛОIT

(Signed) O.G. Bleedorn  
OGB

County Surveyor.

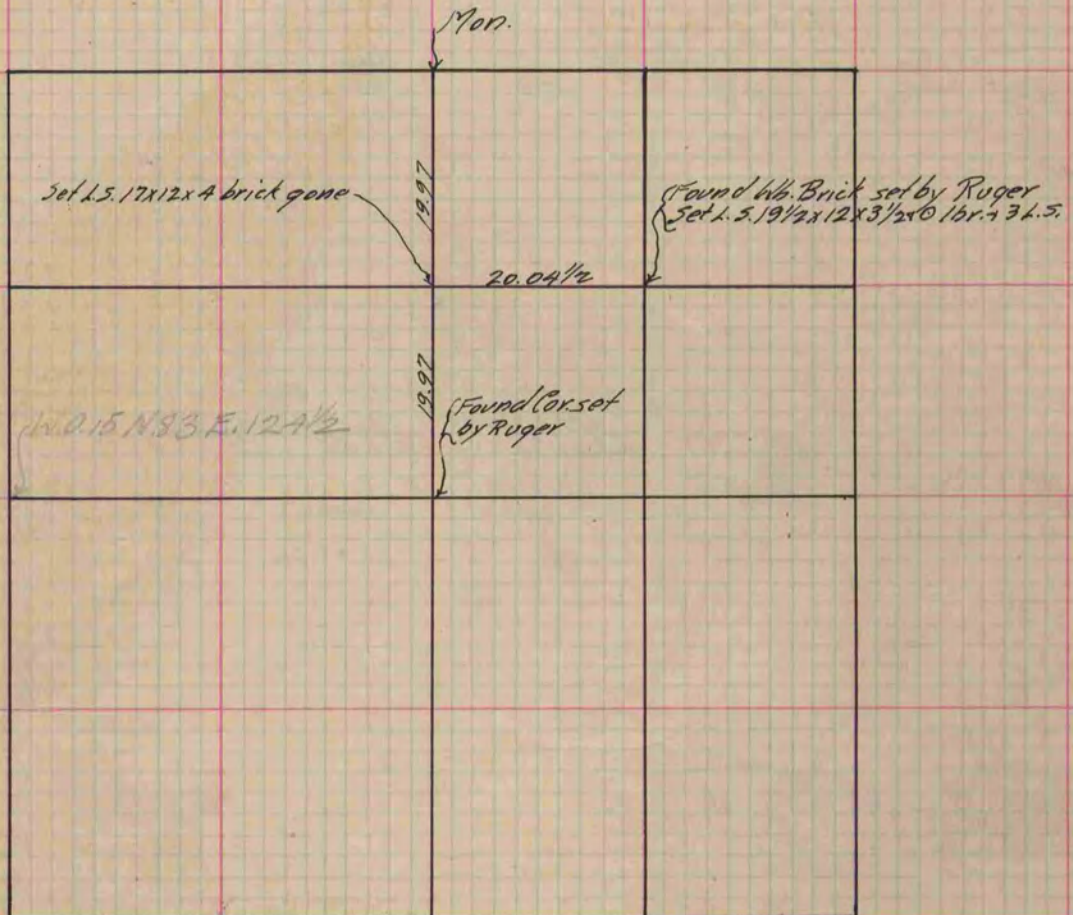

*Copied from Page 370 Vol. 2 County Surveyor's Record.*