

PLAT AND RECORD

Of a Survey on Section 24 T 2 R 10 E. of the 4 P. M. in Spring Valley Township


Rock County, Wisconsin, made May the 21 1886

I hereby certify that the following is a correct record of said survey as made by me.

COUNTY BUILDING
IN CITY OF BELOIT

(Signed) Edward Ruger
E. R. G.

County Surveyor.

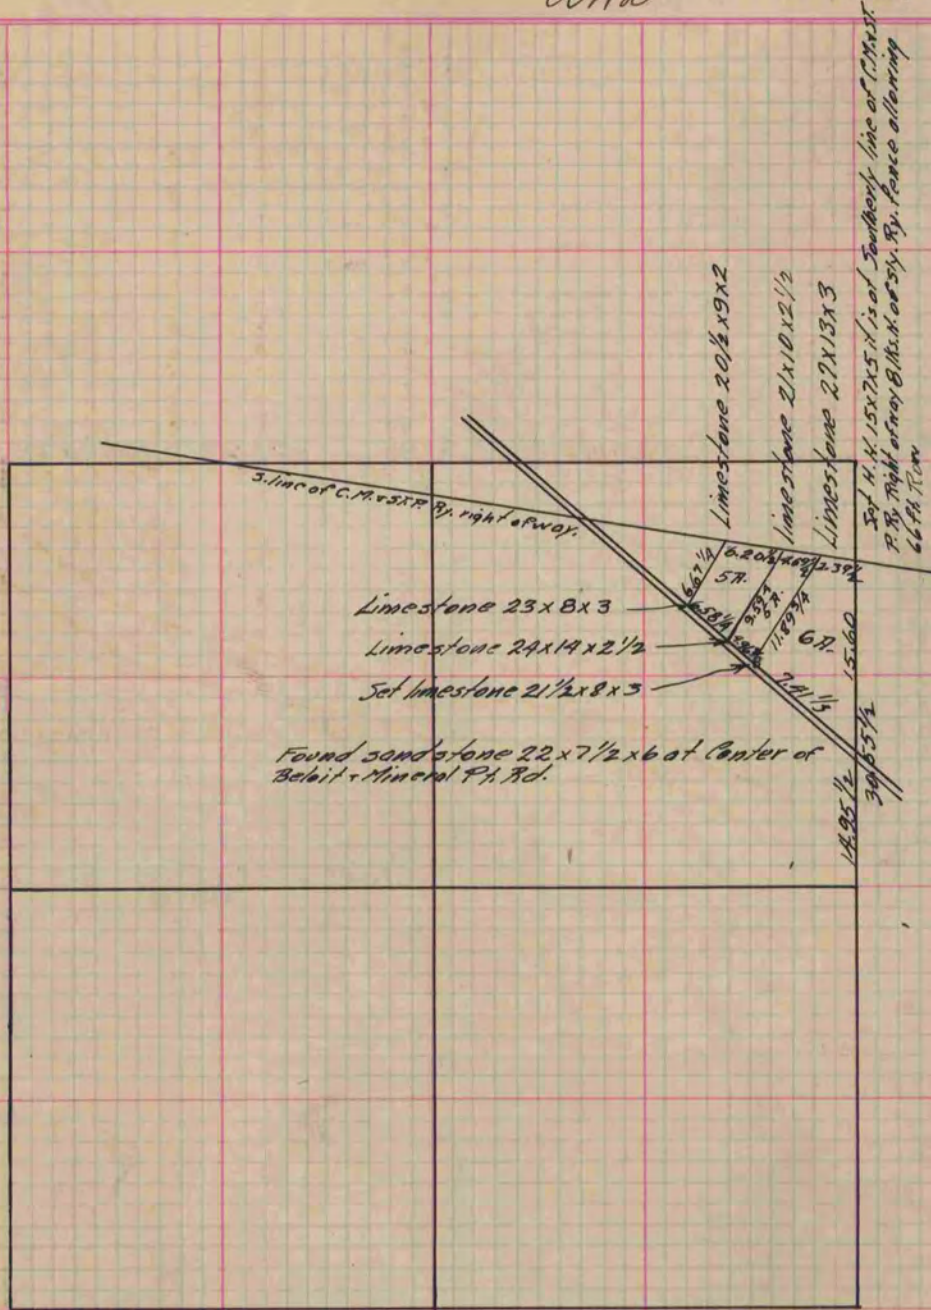

See P. 239

Copied from P. 227 Vol. 2 County Surveyor's Record.