

PLAT AND RECORD


Of a Survey on Section 15 T 3 R 13 E. of the 4 P. M. in Harmony Township
Rock County, Wisconsin, made December the 8th 1881

I hereby certify that the following is a correct record of said survey as made by me.

COUNTY BUILDING
IN CITY OF BELOIT

(Signed) J. A. Holmes
R.A.B. County Surveyor.

50 Acres from N.E. part, of N.W. 1/4 Sec. 15 Harmony

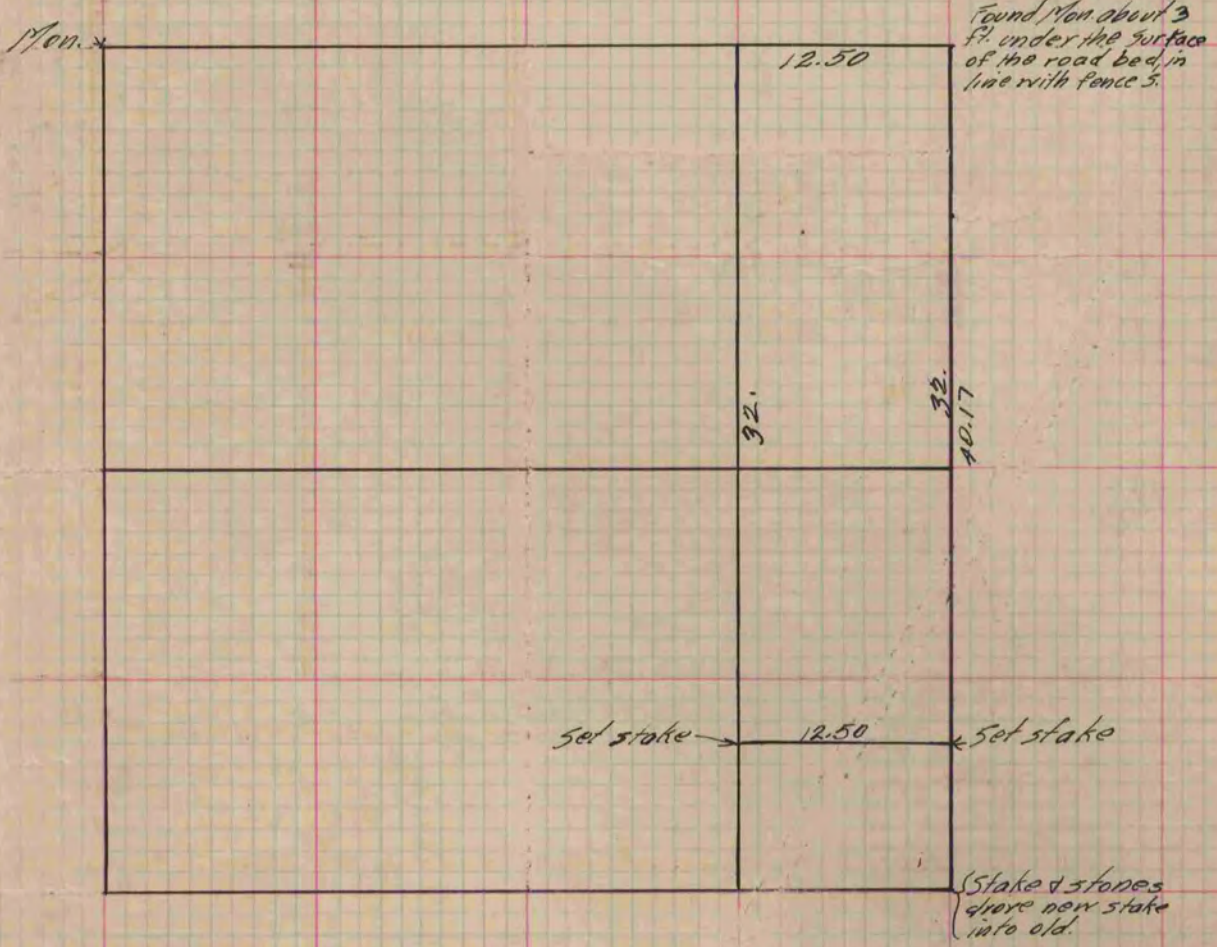

Copied from P. 279 Vol. 2 County Surveyor's Record.