

# PLAT AND RECORD


Of a Survey on Section 23 T 3 R 12 E. of the 4 P. M. in Jamesville Township

Rock County, Wisconsin, made Dec. 20, 21, 22, & 26-1877 & Jan. 3+4 the 1878

COUNTY BUILDING IN CITY OF BELOIT  
I hereby certify that the following is a correct record of said survey as made by me.

(Signed) Edward Puger  
RMB

County Surveyor.

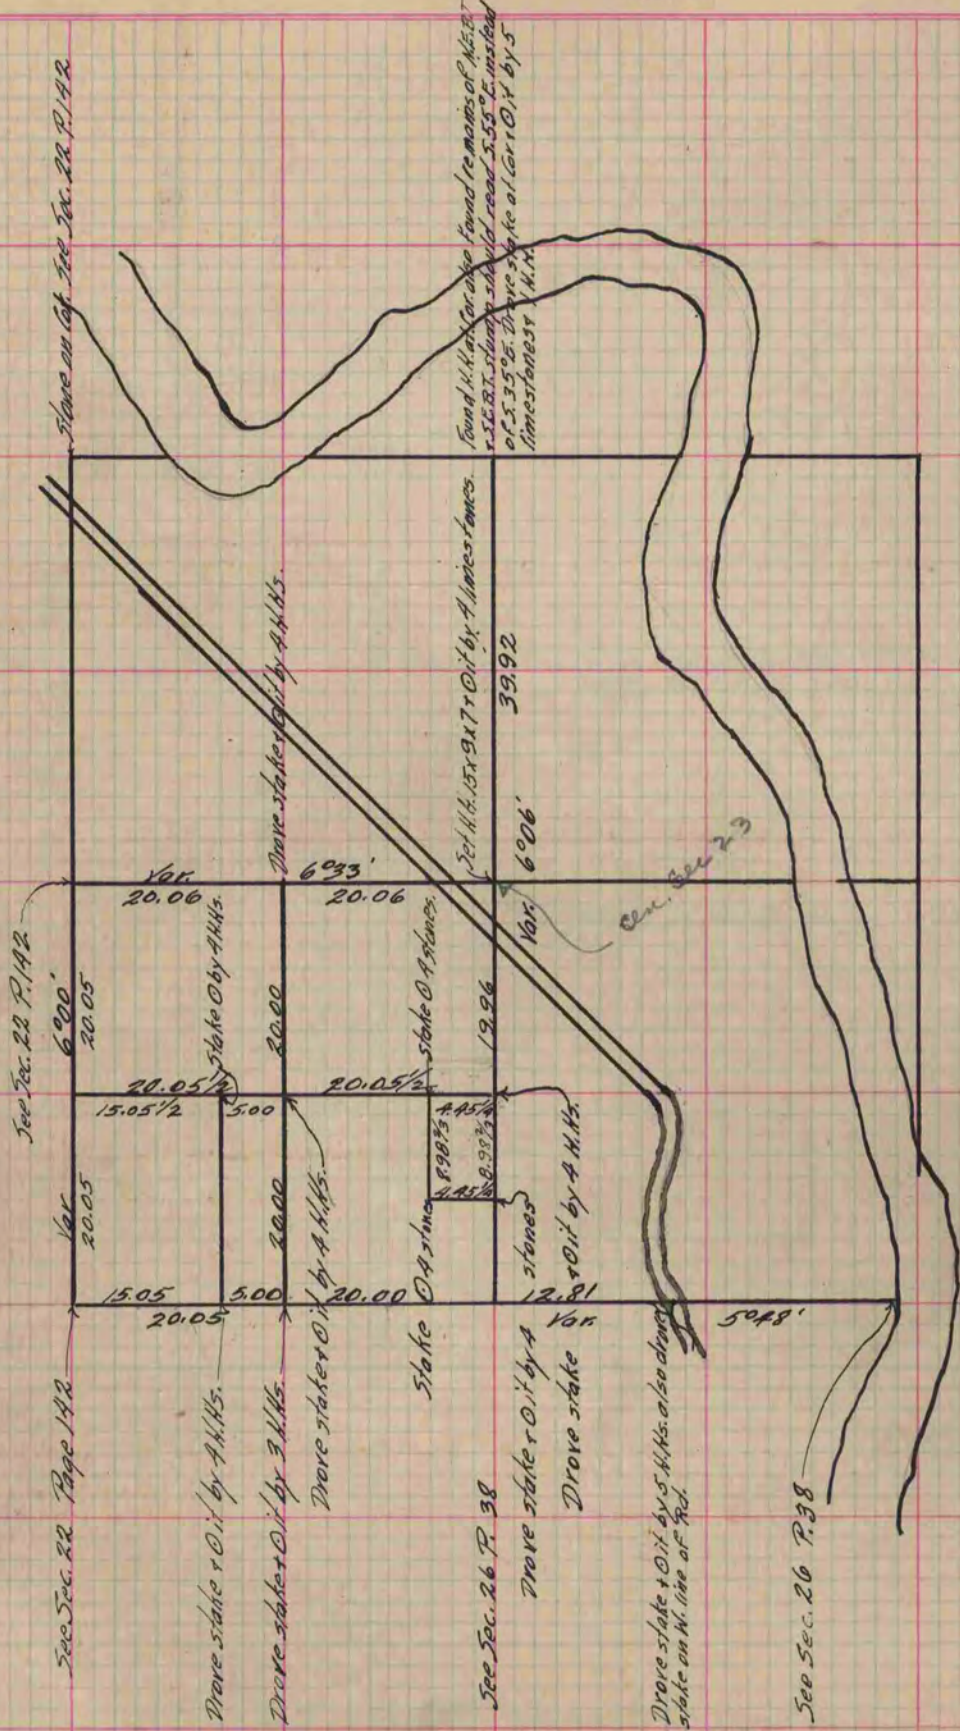

*Copied from P. 192 Vol. 2 Original County Surveyor's Record.*