

PLAT AND RECORD


Of a Survey on Section 13 T 2 R 12 E. of the 4 P. M. in Rock Township
Rock County, Wisconsin, made June the 21 1877

I hereby certify that the following is a correct record of said survey as made by me.

COUNTY BUILDING
IN CITY OF BELOIT

(Signed) *Edward Ruger*
R.A.B.

County Surveyor.

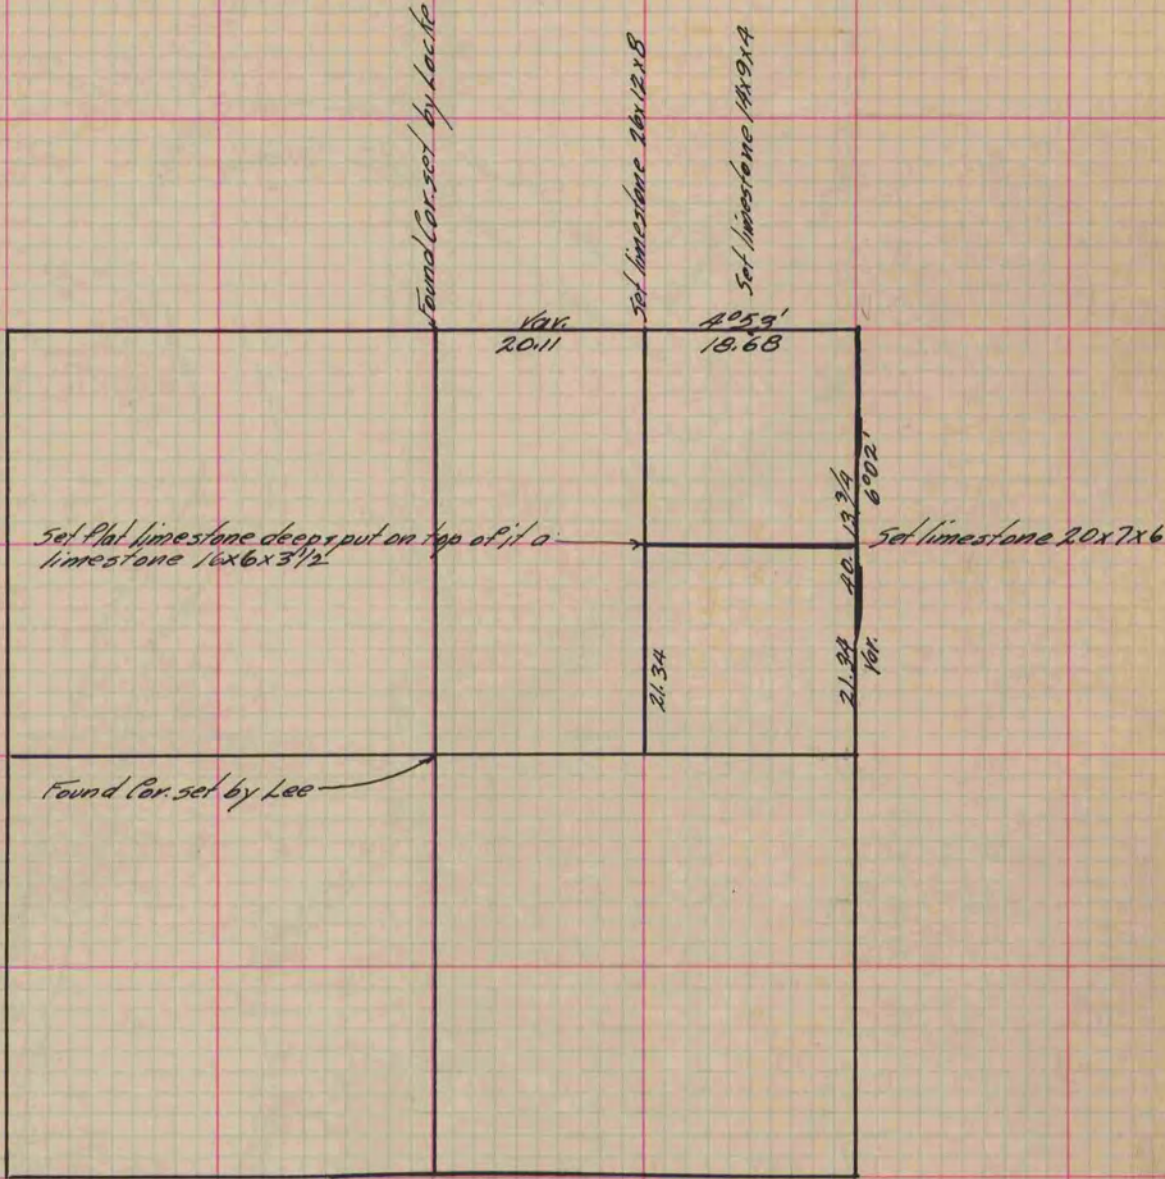

Copied from P. 191 Vol. 2 Original County Surveyors Record.