

# PLAT AND RECORD


Of a Survey on Section 1 T A R 11 E. of the 4 P. M. in Porter Township

Rock County, Wisconsin, made March the 27 1874

I hereby certify that the following is a correct record of said survey as made by me.

COUNTY BUILDING  
IN CITY OF BELOIT

(Signed) Edward Ruger  
County Surveyor.

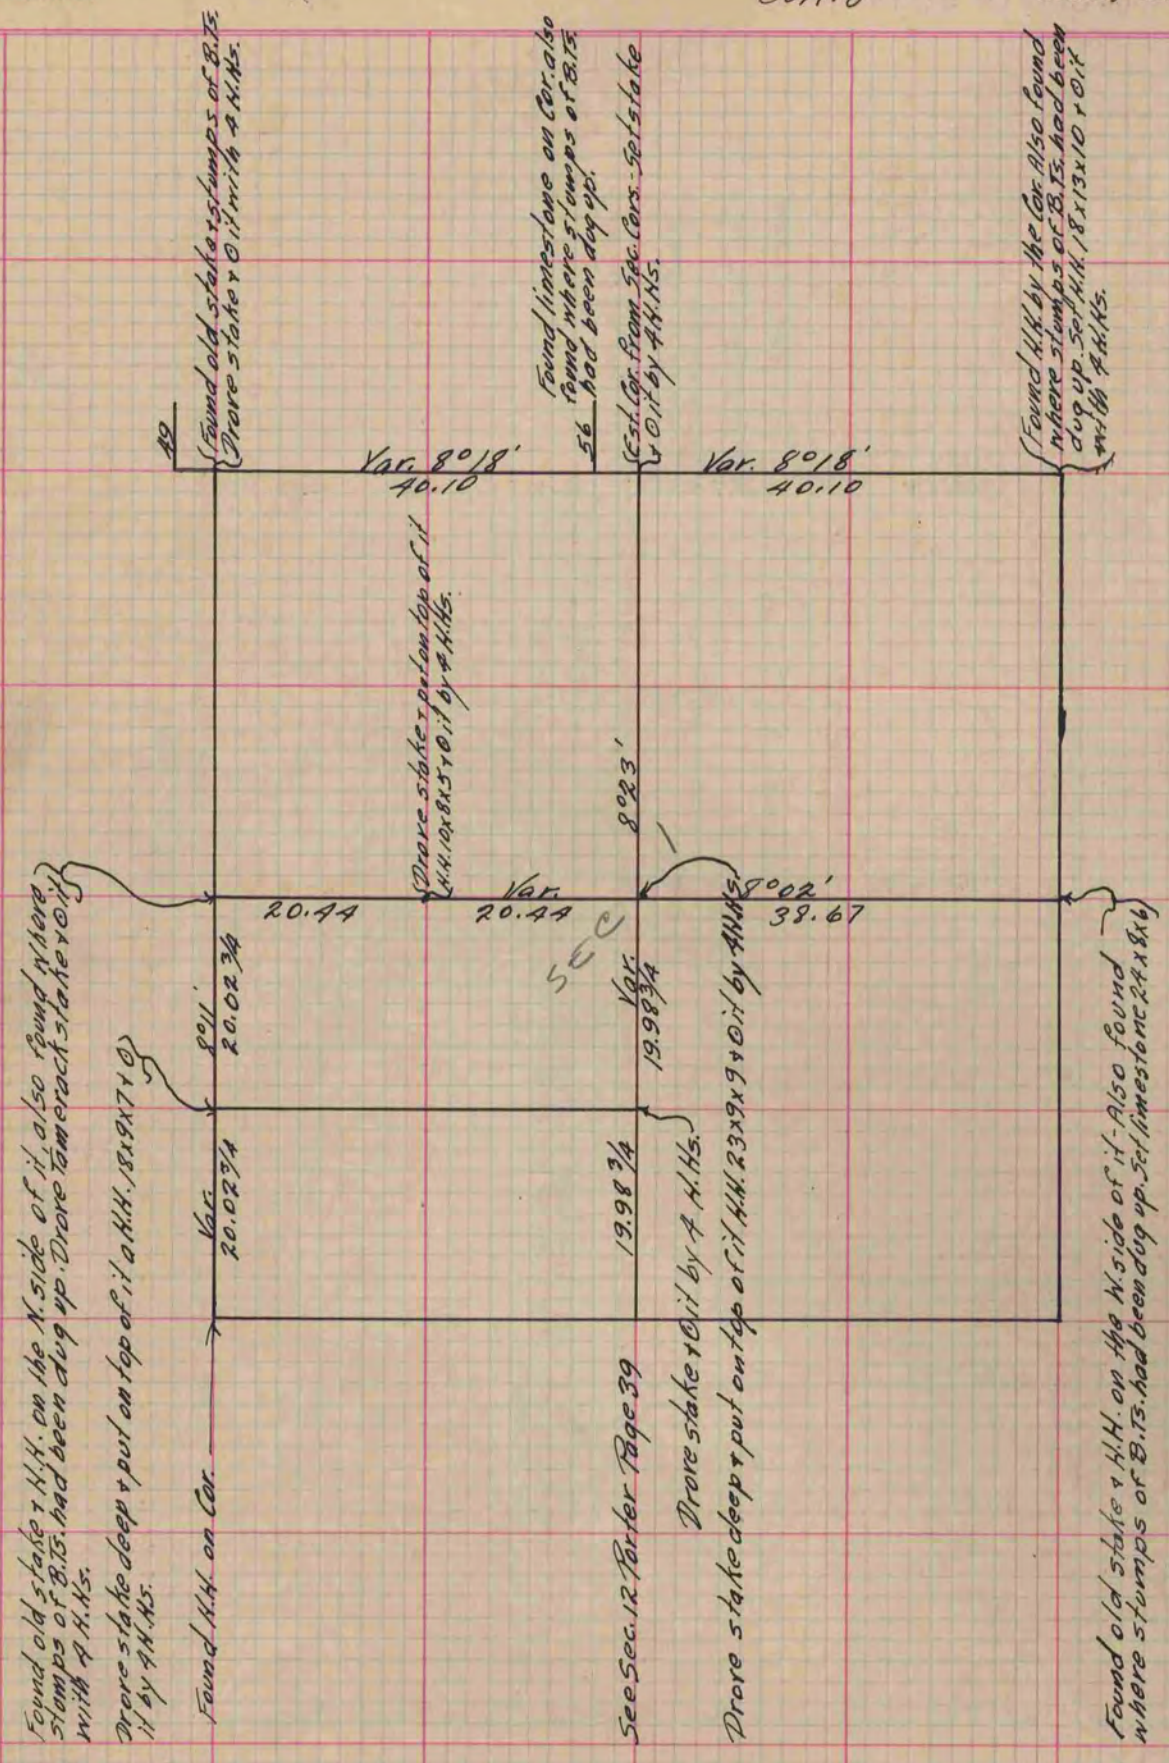

Copied from P. 86 Vol. 2 Original County Surveyor's Record.