

PLAT AND RECORD

Of a Survey on Section 27 T 4 R 12 E. of the 4 P. M. in Fulton Township


Rock County, Wisconsin, made April the 8th 1867

I hereby certify that the following is a correct record of said survey as made by me.

COUNTY BUILDING
IN CITY OF БЕЛОIT

(Signed) S.D. Locke.
S.D.L.

County Surveyor.

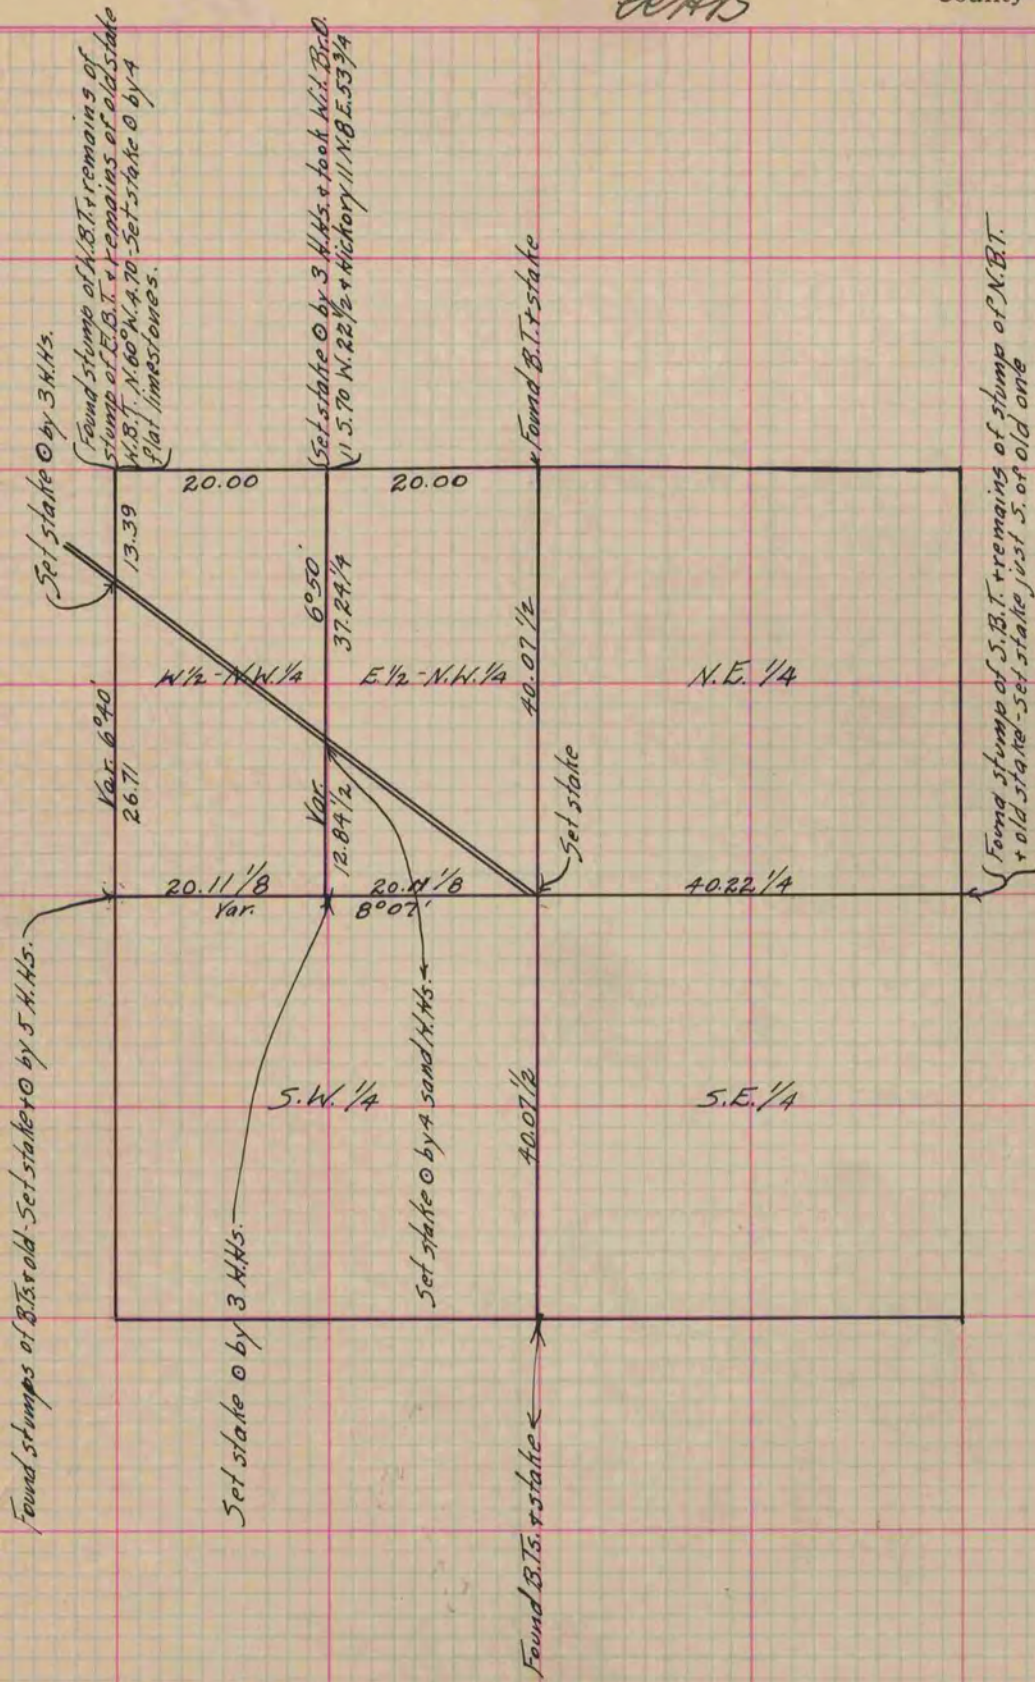

Copied from Page 245 Vol. Original County Surveyor's Record.