


PLAT AND RECORD

Of a Survey on Section 19 T 3 R 13 E. of the 4 P. M. in Harmony Township
Rock County, Wisconsin, made March the 20 1874

I hereby certify that the following is a correct record of said survey as made by me.

COUNTY BUILDING
IN CITY OF БЕЛОIT

(Signed) Edward Ruger
CRAB County Surveyor.

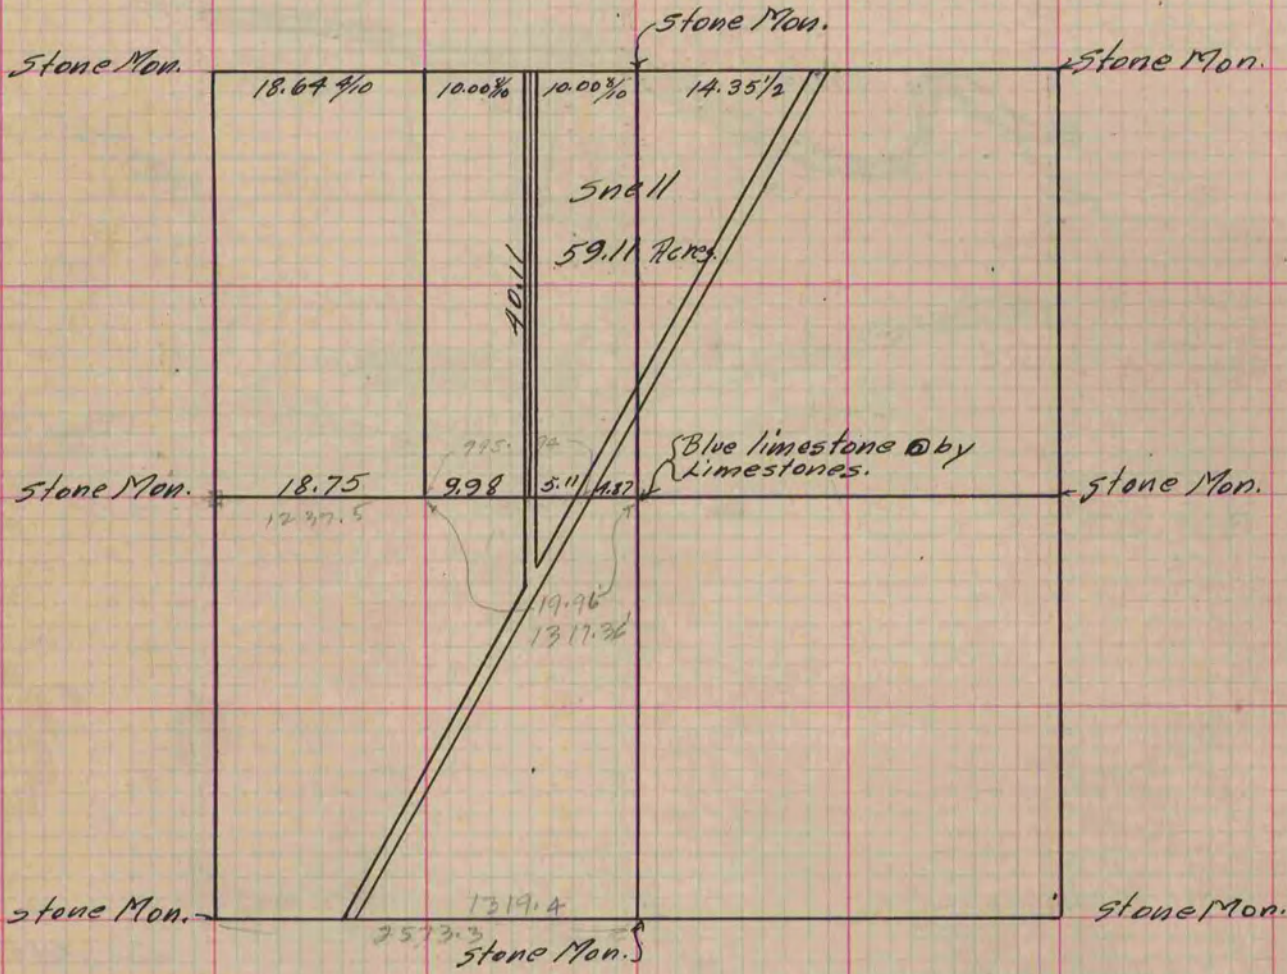

4.27
1.5
9.78

Copied from Page 84 Vol. 2 Original County Surveyor's Record.