

PLAT AND RECORD

Of a Survey on Section 36 T 2 R 12 E. of the 4 P. M. in Rock Township


Rock County, Wisconsin, made September the 1st 1876

I hereby certify that the following is a correct record of said survey as made by me.

COUNTY BUILDING
IN CITY OF БЕЛОIT

(Signed) Edward Ruger

County Surveyor.

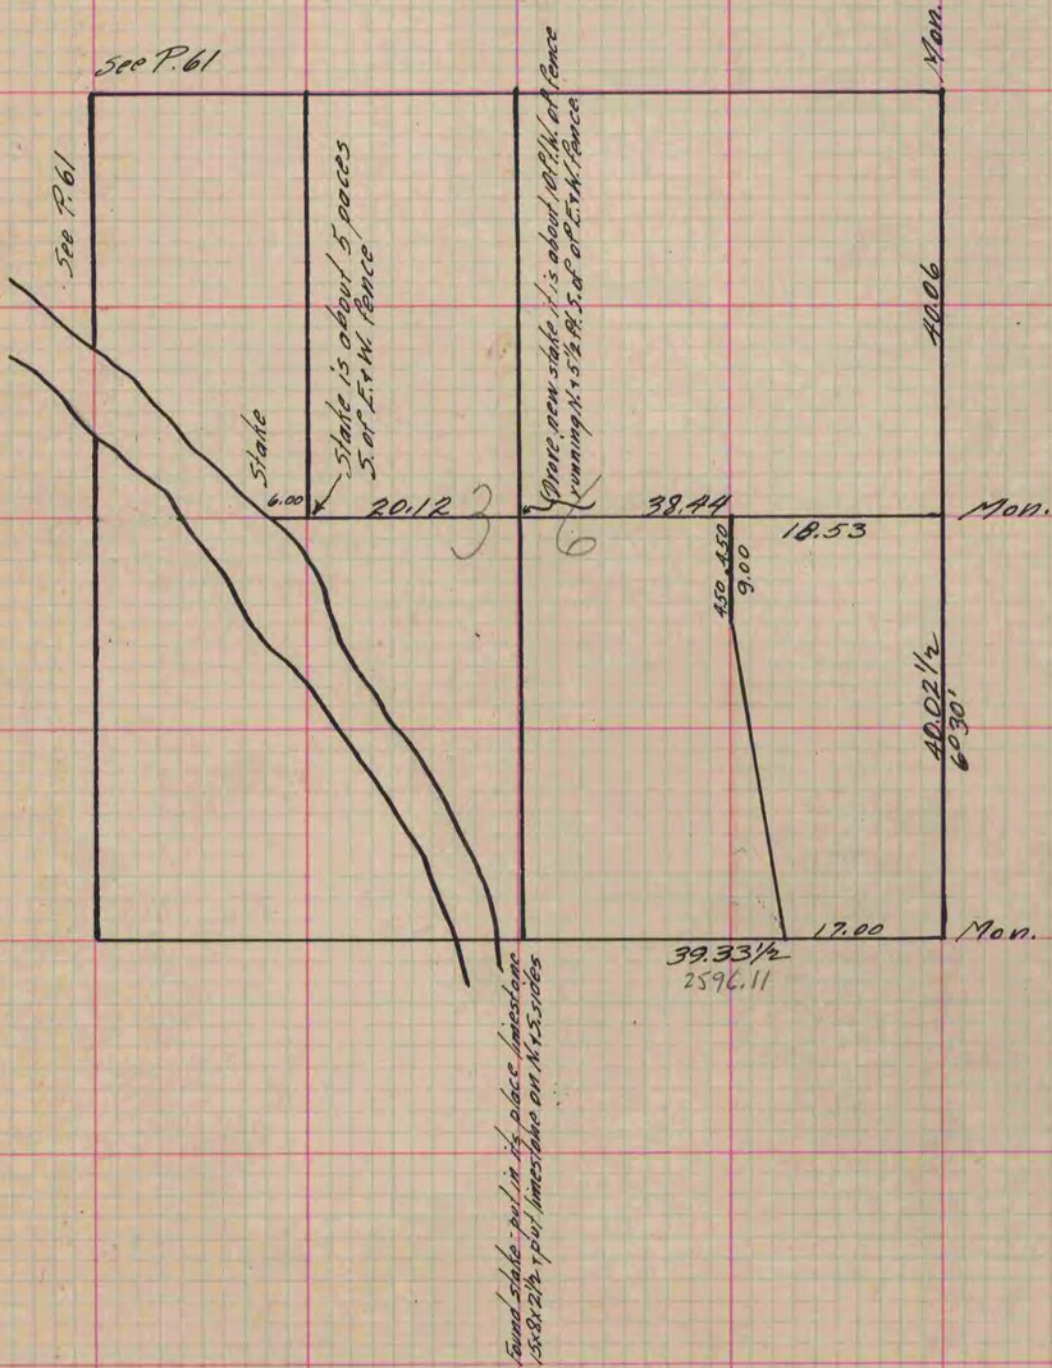

Copied from P. 170 Vol. 2 Original County Surveyor's Record.