

PLAT AND RECORD

Of a Survey on Section 15 T 4 R 13 E. of the 4 P. M. in Milton Township


Rock County, Wisconsin, made May the 22nd 1879

I hereby certify that the following is a correct record of said survey as made by me.

COUNTY BUILDING
IN CITY OF BELOIT

(Signed) *Edward Reger*
RRR

County Surveyor.

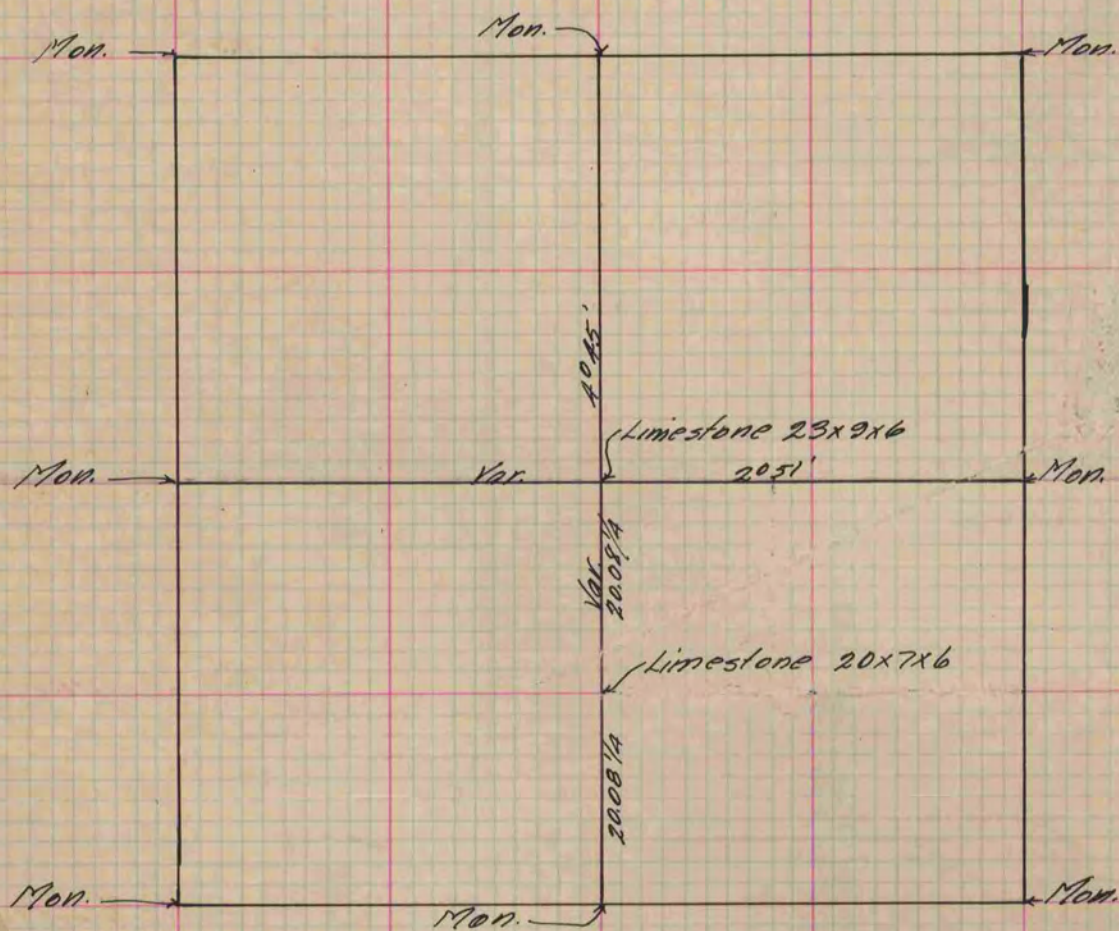

Copied from P. 221 Vol. 2 Original County Surveyor's Record.