


PLAT AND RECORD

Of a Survey on Section 3 T 1 R 10 E. of the 4 P. M. in Avon Township
 & Section 34 T 2 R 10 Spring Valley
 Rock County, Wisconsin, made June the 9th 1879

I hereby certify that the following is a correct record of said survey as made by me.

COUNTY BUILDING
 IN CITY OF BELOIT

(Signed) Edward Ruger
 R.R.B. County Surveyor.

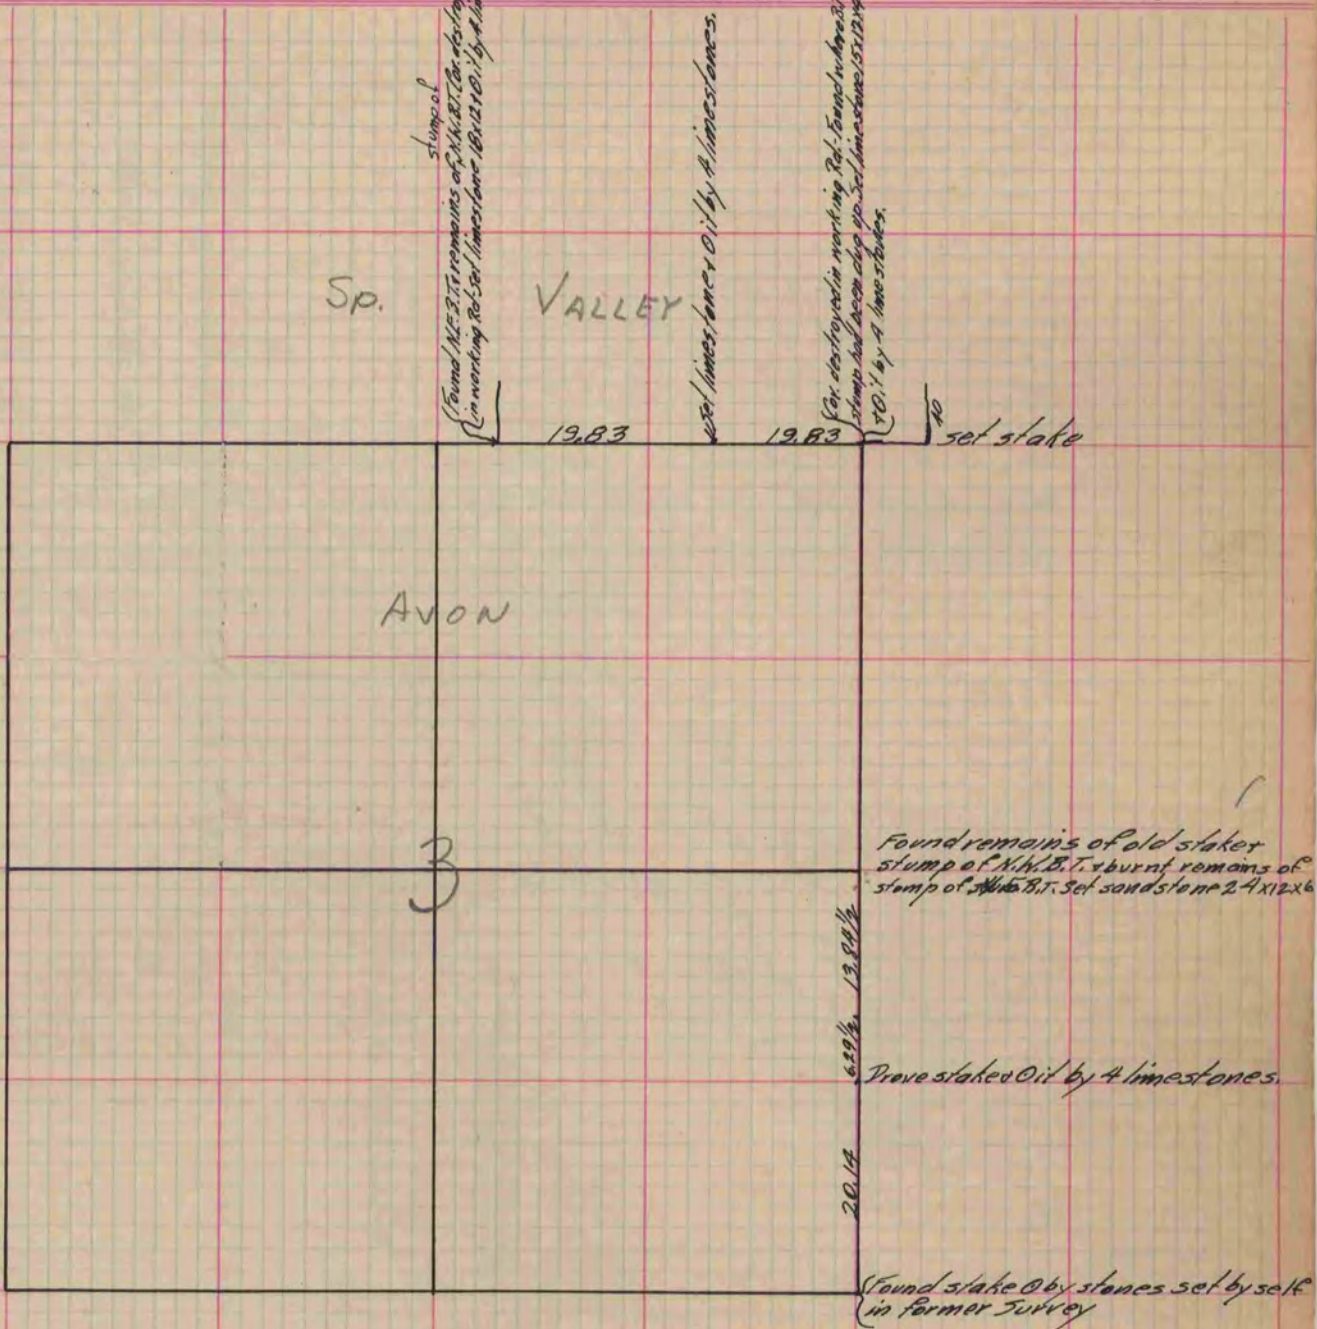

Copied from P. 222 Vol. 2 Original County Surveyor's Record.