

PLAT AND RECORD


Of a Survey on Section 3 T 3 R 13 E. of the 4 P. M. in Harmony Township
Rock County, Wisconsin, made October the 20 1886

I hereby certify that the following is a correct record of said survey as made by me.

COUNTY BUILDING
IN CITY OF БЕЛОIT

(Signed) Edward Reger
ERR

County Surveyor.

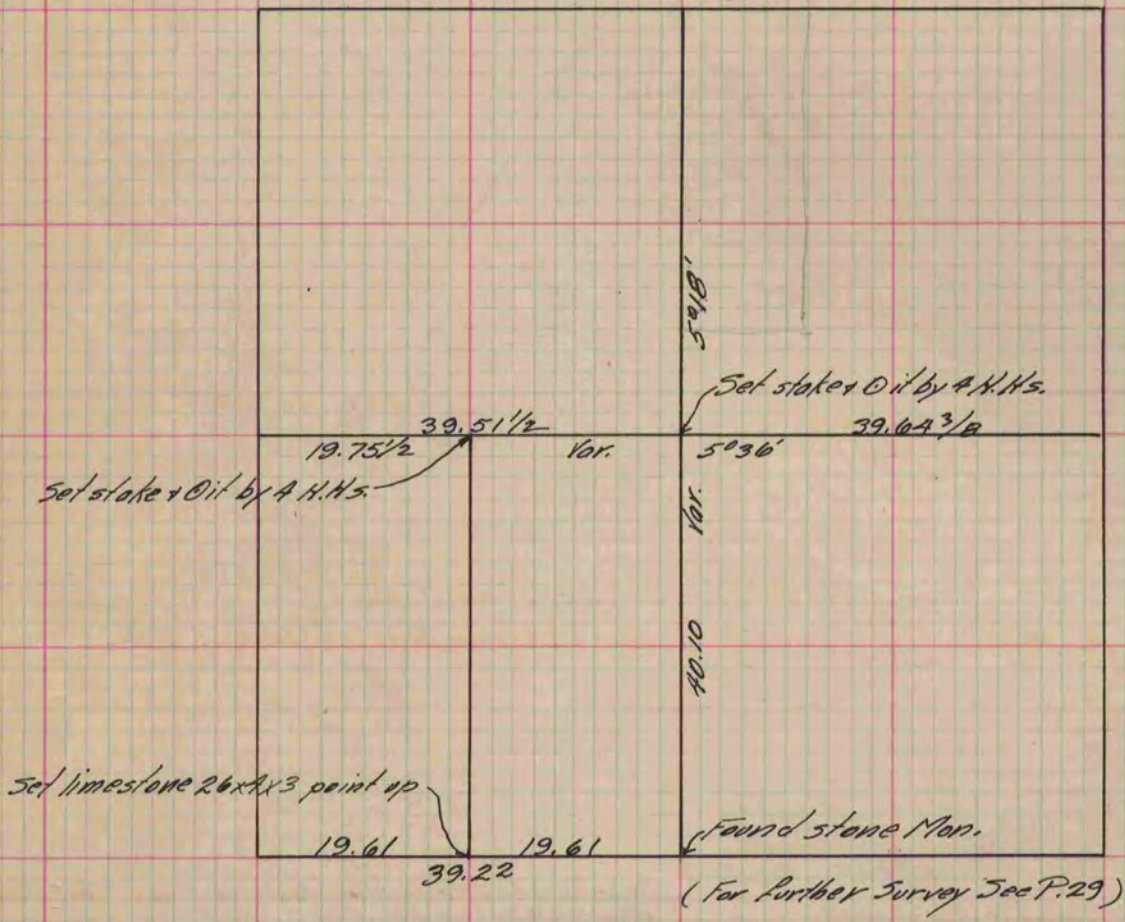

Copied from P. 230 Vol. 2 County Surveyor's Record