

# PLAT AND RECORD

267


Of a Survey on Section 30 T 2 R 10 E. of the 4 P. M. in *Spring Valley* Township  
Rock County, Wisconsin, made *April* the *4th + 5th* 1877

I hereby certify that the following is a correct record of said survey as made by me.

COUNTY BUILDING  
IN CITY OF BELOIT

(Signed) *Edward Ruger*

County Surveyor.

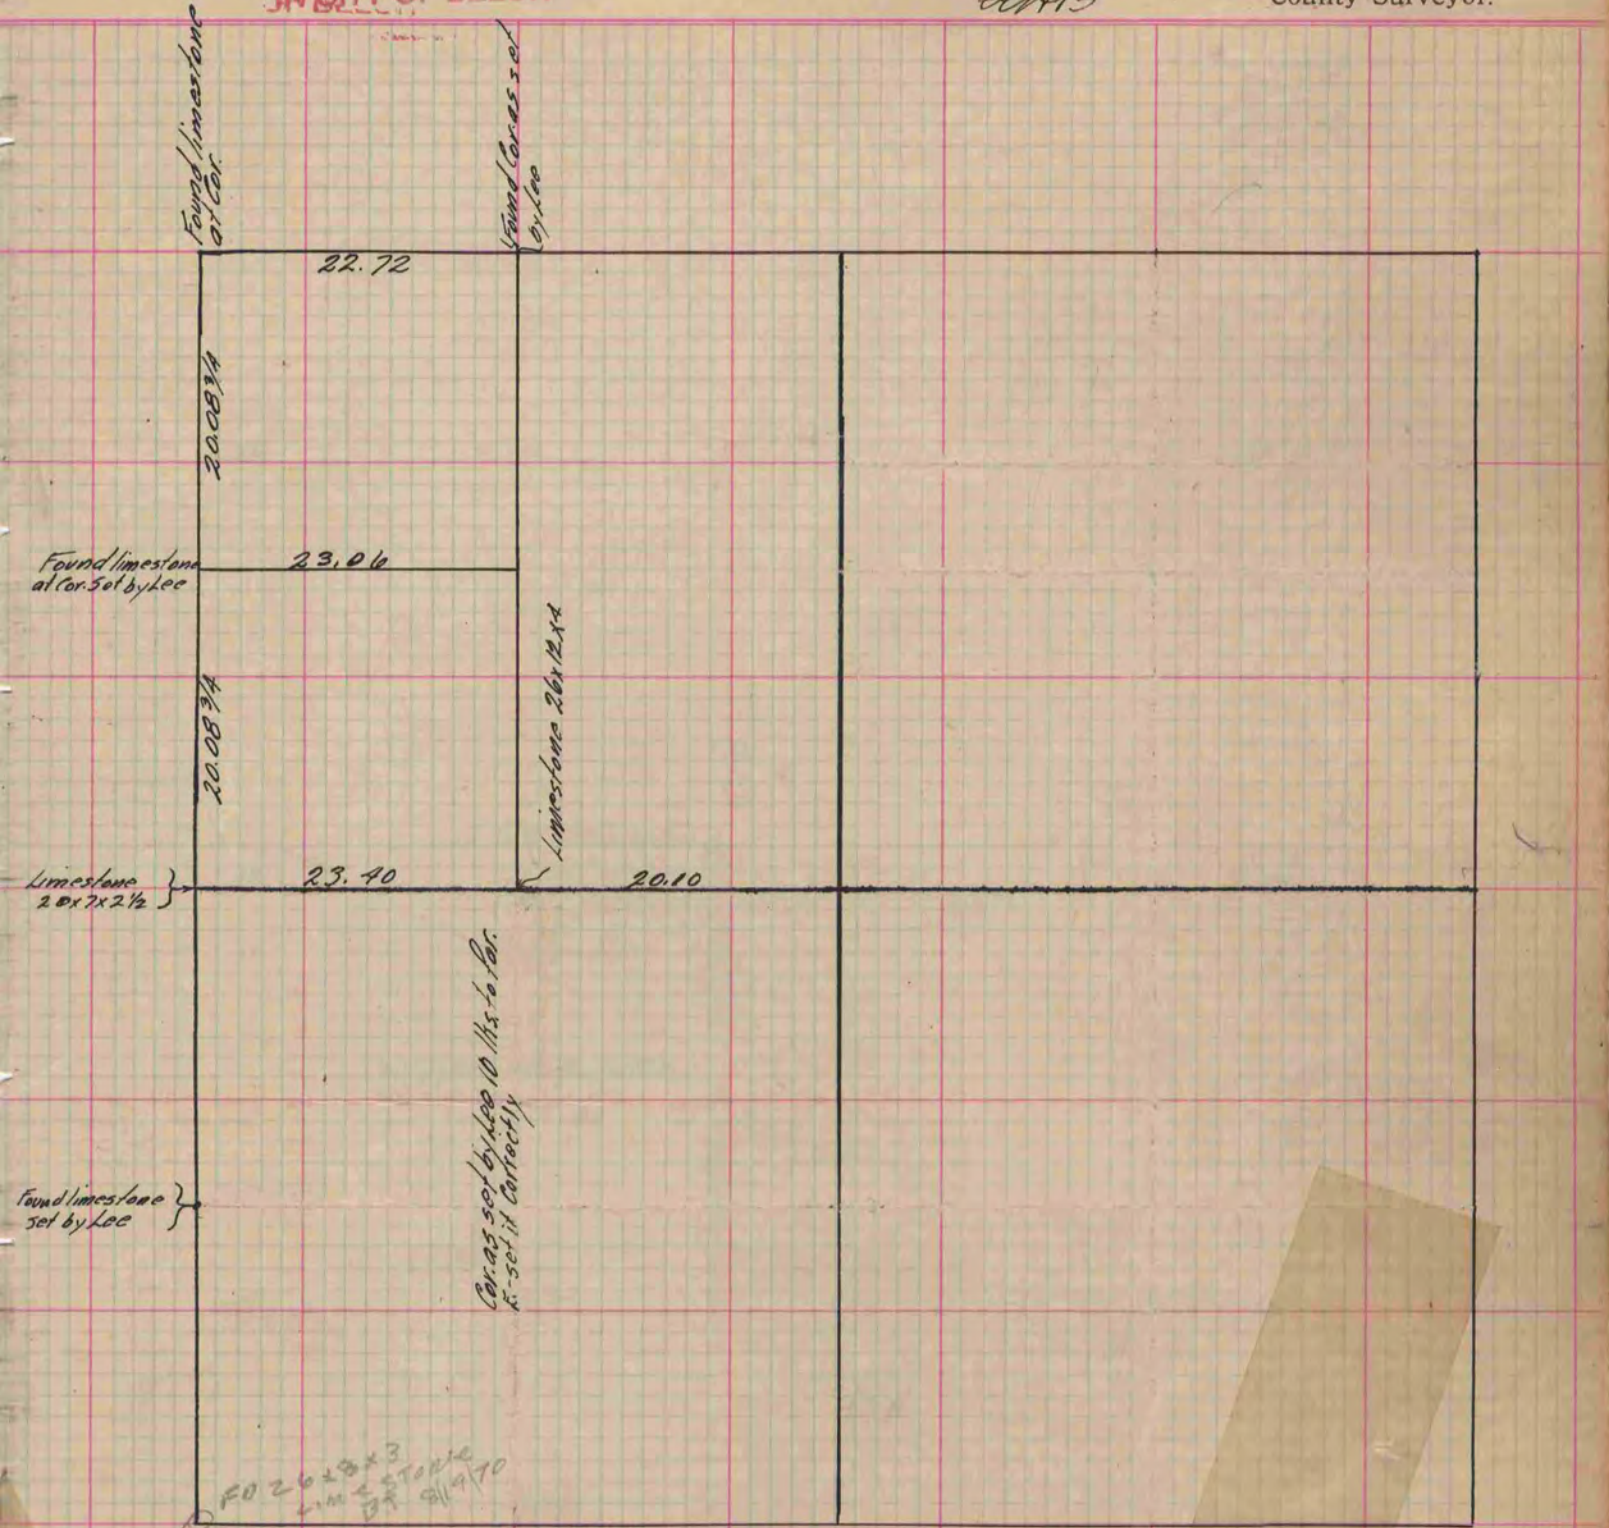

*Copied from P. 202 Vol. 2 Original County Surveyor's Record.*