

# PLAT AND RECORD

259

Of a Survey on Section 17 T 1 R 12 E. of the 4 P. M. in Beloit Township


Rock County, Wisconsin, made June the 20 1878

I hereby certify that the following is a correct record of said survey as made by me.

COUNTY BUILDING  
IN CITY OF BELOIT

(Signed) Edward Ruger  
R.A.B.

County Surveyor.

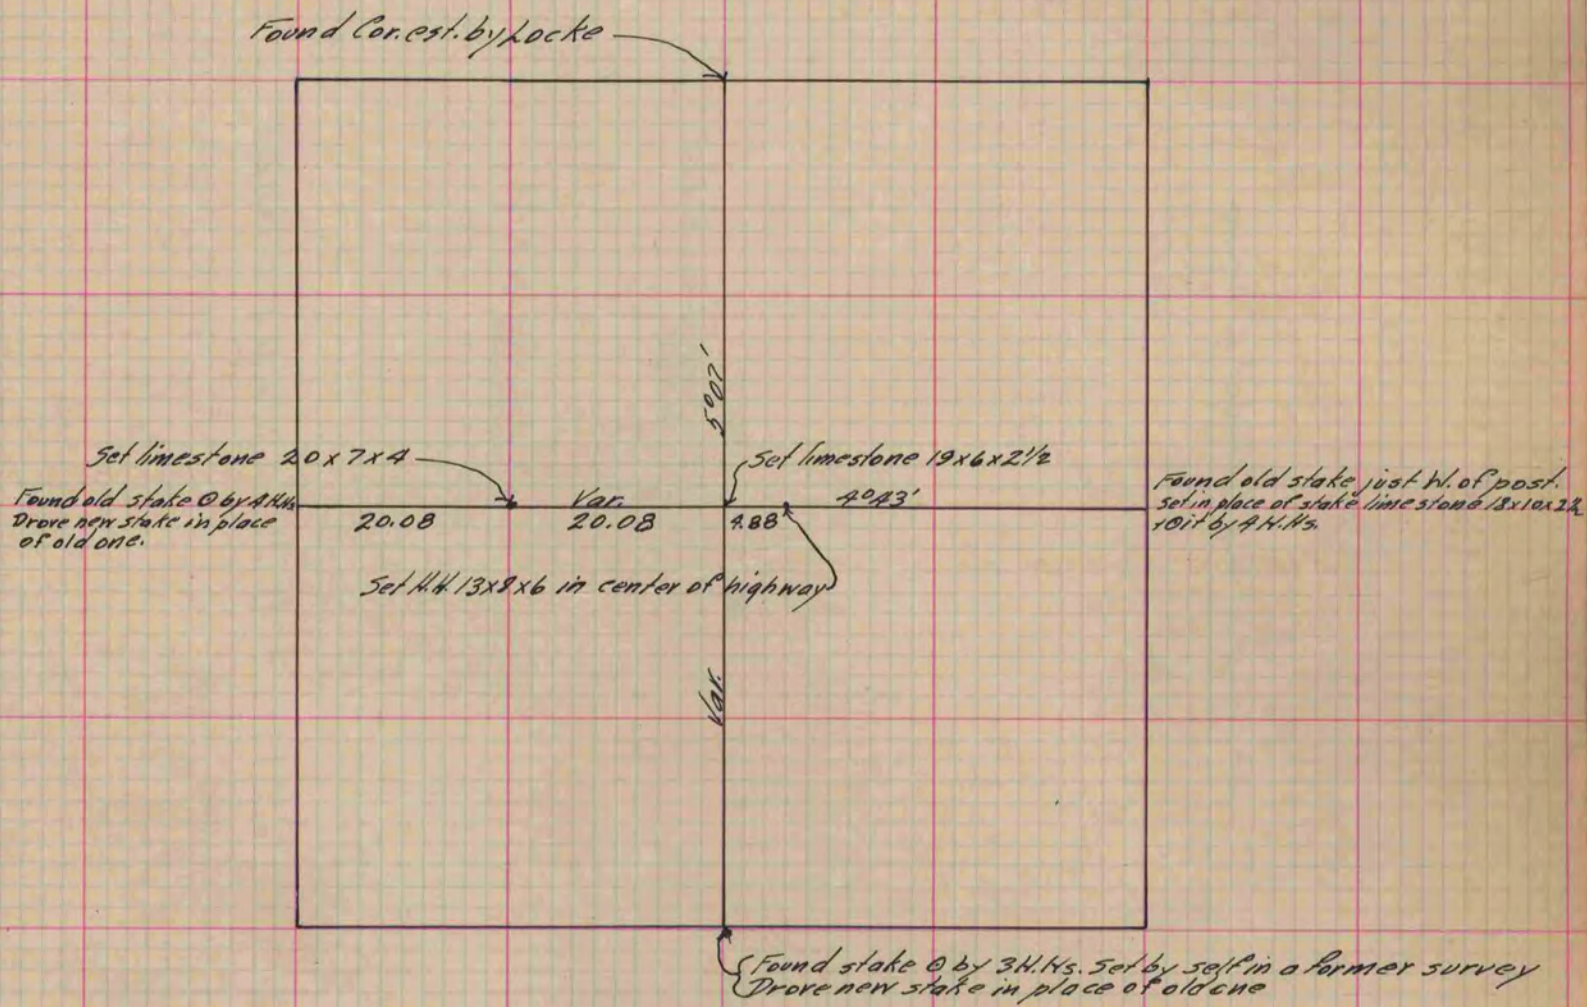

Copied from P. 213 Vol. 2 County Surveyor's Record