

# PLAT AND RECORD


Of a Survey on Section 8 T 3 R 13 E. of the 4 P. M. in Harmony Township  
Rock County, Wisconsin, made May the 22 1878

I hereby certify that the following is a correct record of said survey as made by me.

COUNTY BUILDING  
IN CITY OF BELOIT

(Signed) Edward Ruger.  
ERTS

County Surveyor.

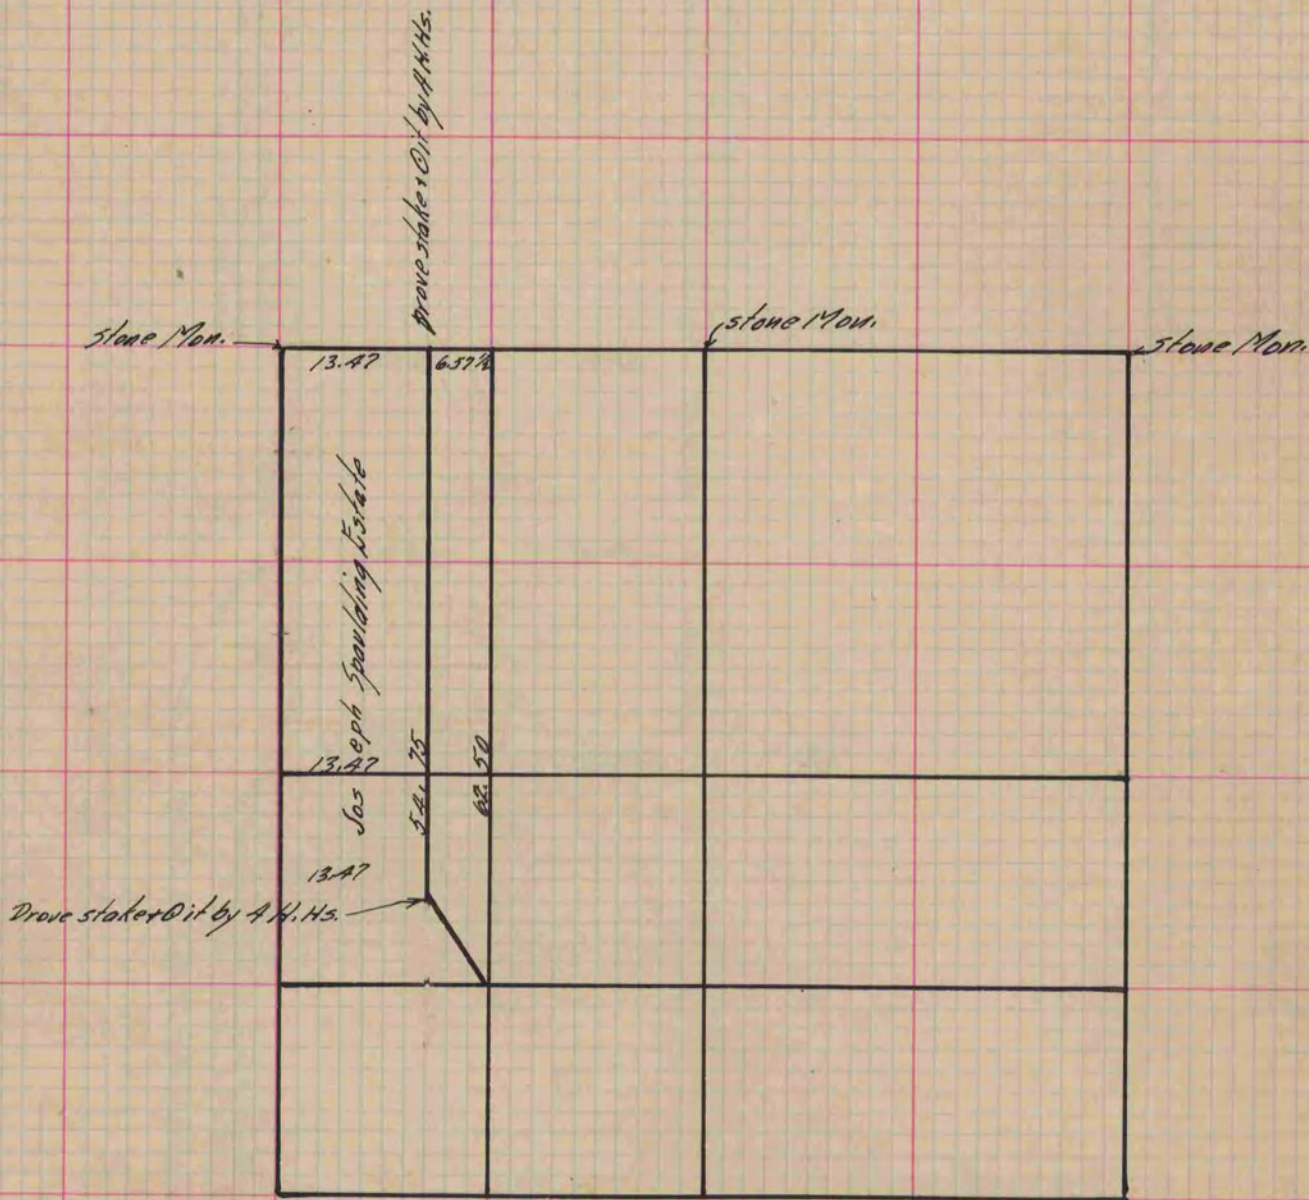

Copied from P. 209 Vol. 2 County Surveyor's Record.