

PLAT AND RECORD


Of a Survey on Section 34 T 2 R 14 E. of the 4 P. M. in Bradford Township
Rock County, Wisconsin, made June the 6+7 1878

I hereby certify that the following is a correct record of said survey as made by me.

COUNTY BUILDING
IN CITY OF БЕЛОIT

(Signed) Edward Ruger
C.S.S.

County Surveyor.

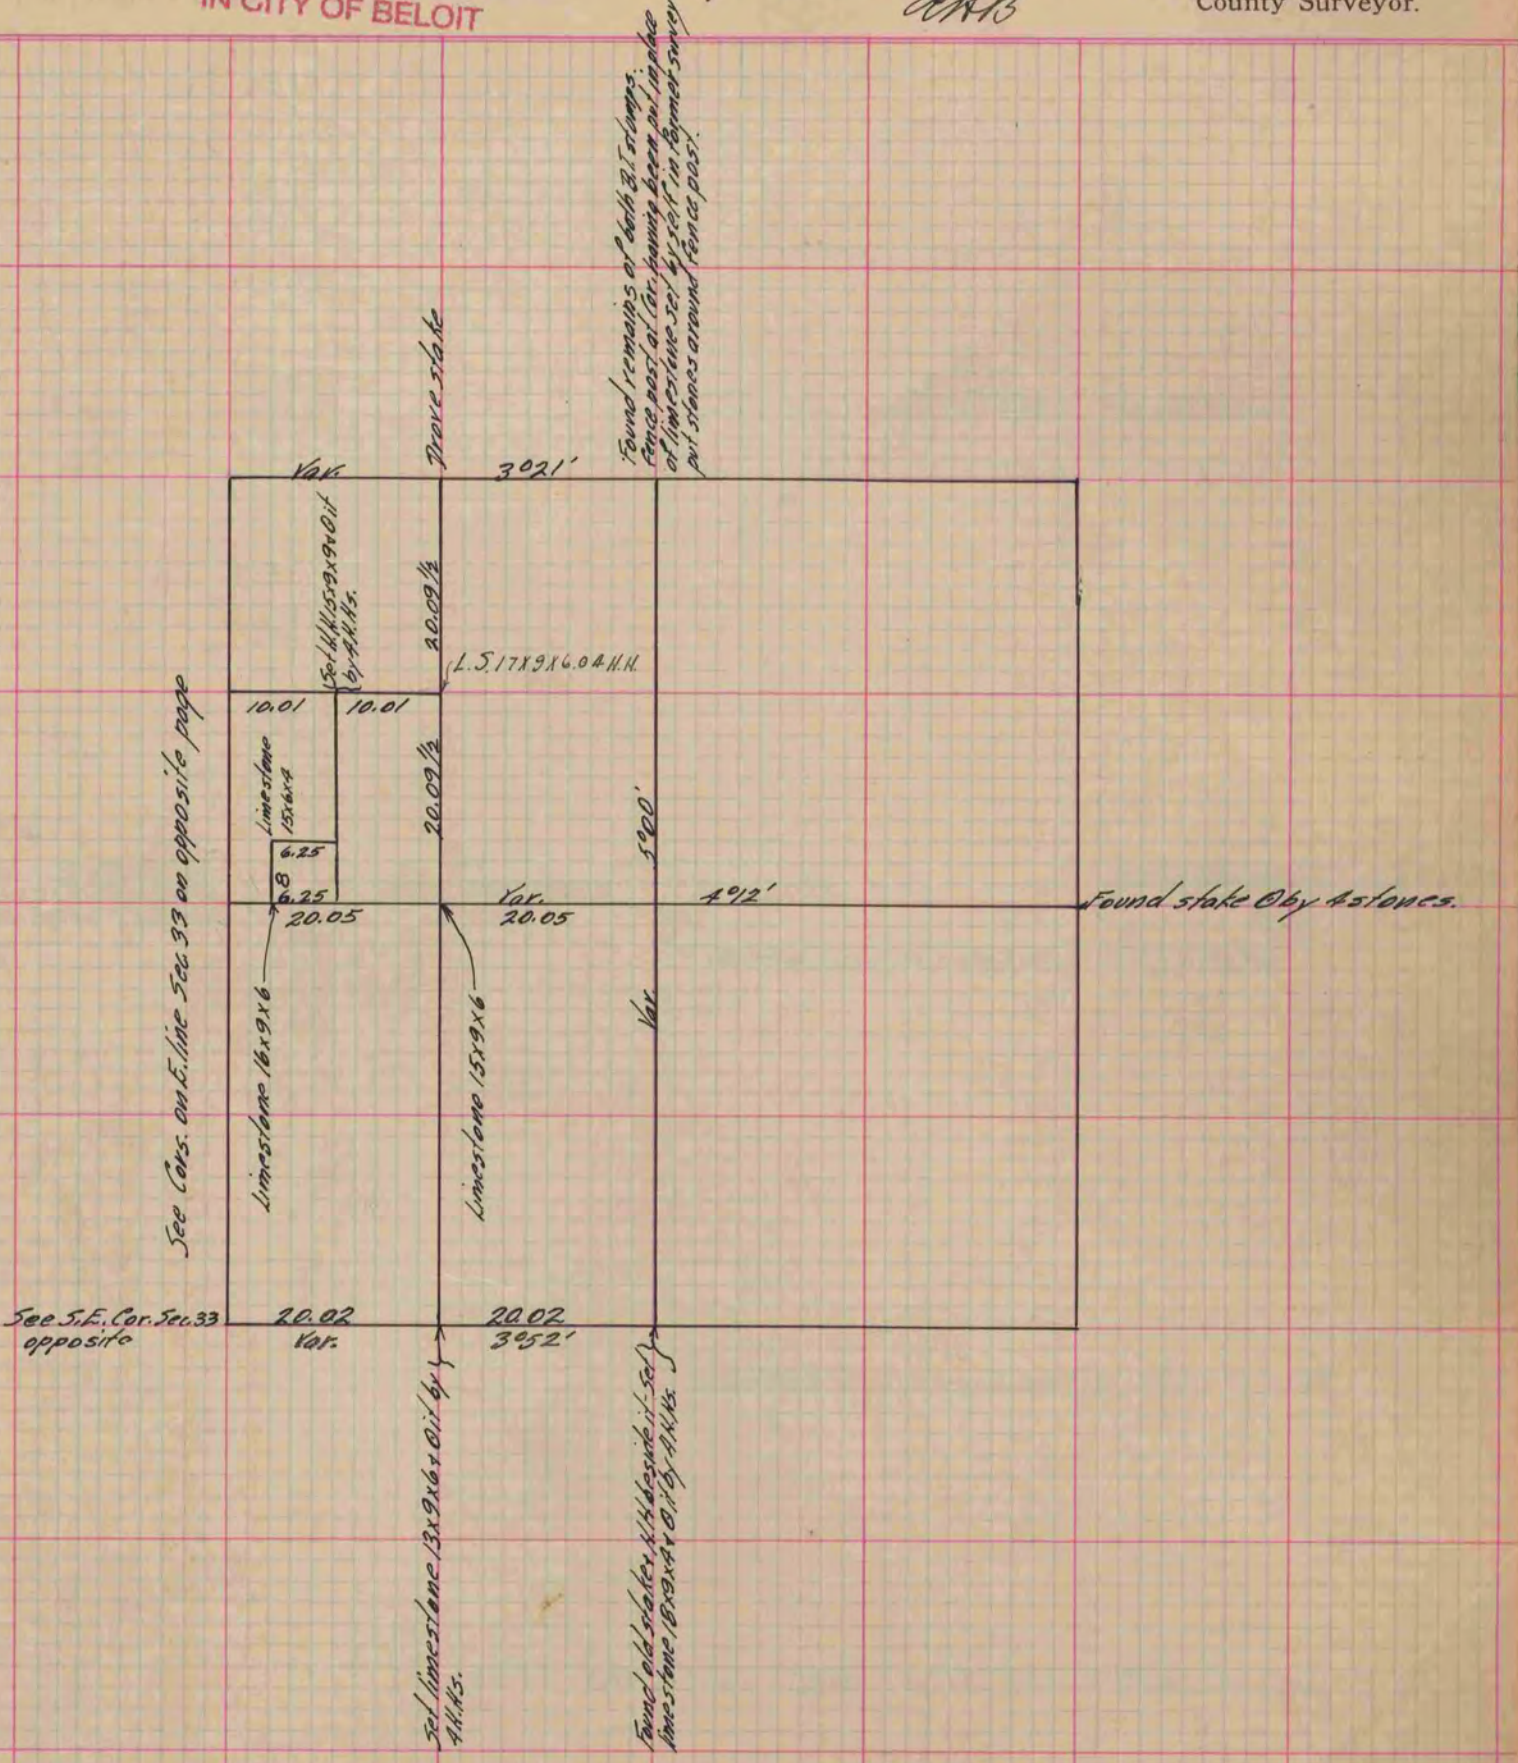

Copied from P. 211 Vol. 2 County Surveyor's Record.