

PLAT AND RECORD

Of a Survey on Section 24 T 3 R 10 E. of the 4 P. M. in MAGNOLIA Township

Rock County, Wisconsin, made NOVEMBER the 29 1968


I hereby certify that the following is a correct record of said survey as made by me.

COUNTY BUILDING
IN CITY OF БЕЛОIT

Robert E. Ma

County Surveyor.

NOTE: ALL REFERENCES 1" PIPES.

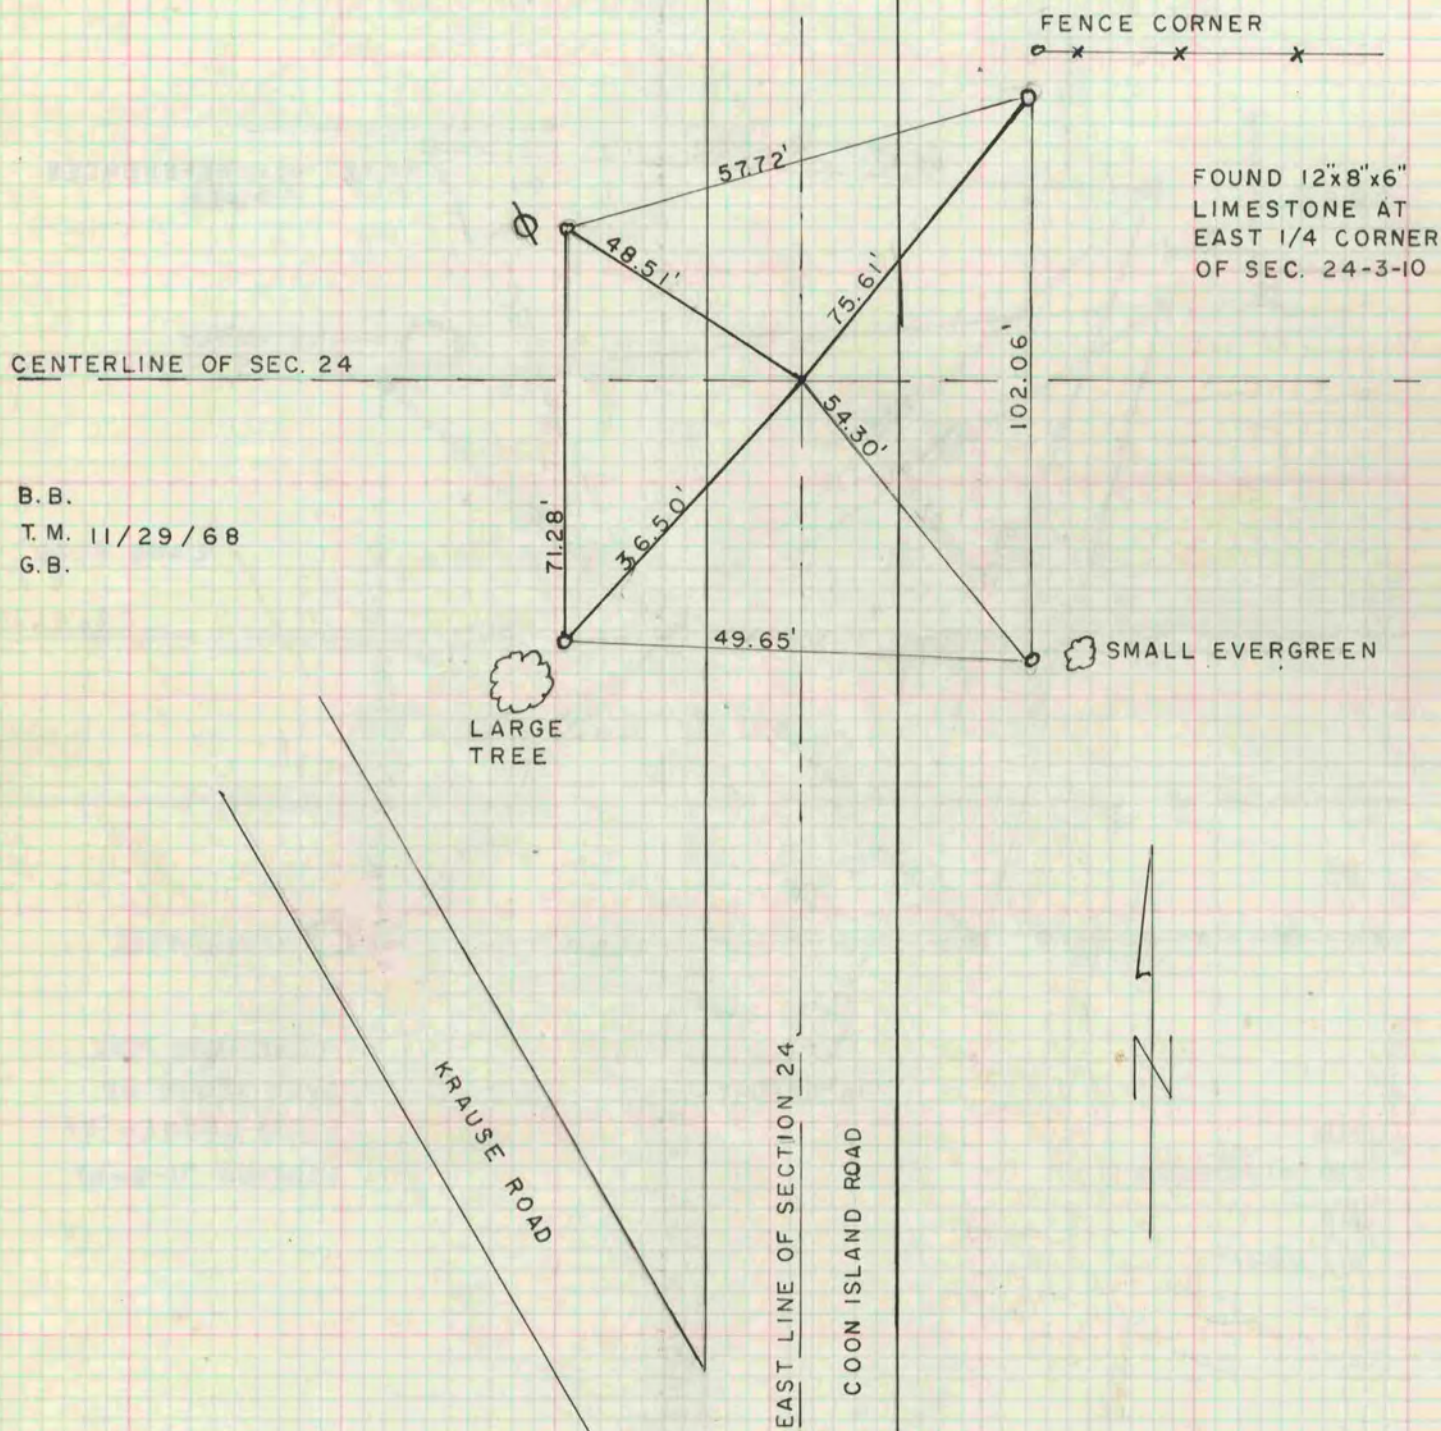

B.B.
T.M. 11/29/68
G.B.