

# PLAT AND RECORD

Of a Survey on Section 30 T 4 N. R 11 E. of the 4 P. M. in PORTER Township

Rock County, Wisconsin, made APRIL the 5th 1971



I hereby certify that the following is a correct record of said survey as made by me.

*Angelo J. Lee*  
County Surveyor.

COUNTY BUILDING  
IN CITY OF BELOIT

COUNTY BUILDING  
IN CITY OF BELOIT

AT N. 1/4 COR. SEC. 30, PORTER TWP.  
FD. MON. BOX OVER 1" PIPE  
RE-REFERENC OF REF. FD. IN VOL. 4, P. 439  
APRIL 5, 1971  
J.M.S.  
M.L.

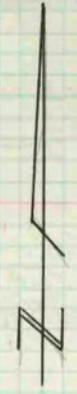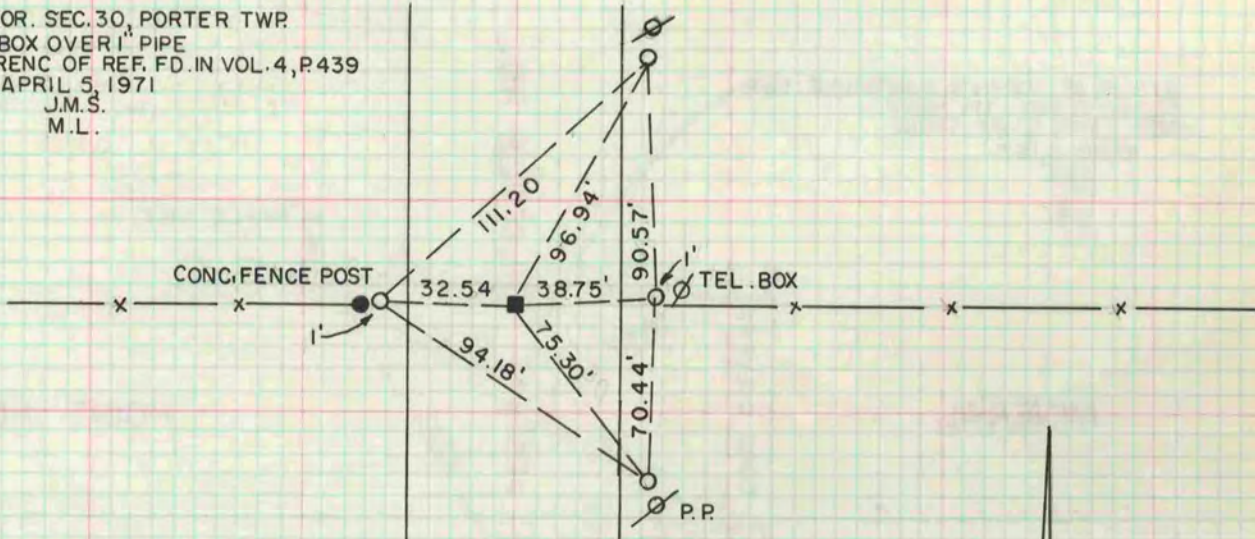

NOTE: 0=1" x 24" IRON PIPE REFERENCE MON.

AT CENTER OF SEC. 30, PORTER TWP.  
SET NEW REFERENCES (OLD REF. IN VOL. 4,  
P. 439.)  
APRIL 5, 1971  
JMS  
M.L.

N. 1/4 COR. OF S.E. 1/4  
SEC. 30-4-11, Fd.  
2 H.H.'S PK'S 8' NE & 8'  
N.W.  
W.D.K.  
J.L.  
G.B. FIELD 5-11-73  
BK. 163, P. 132

