

PLAT AND RECORD

Of a Survey on Section 33 4
4 T 3 R 14 E. of the 4 P. M. in LIMA JOHNSTOWN Township

Rock County, Wisconsin, made AUGUST the 20 1969

I hereby certify that the following is a correct record of said survey as made by me.

**COUNTY BUILDING
IN CITY OF BELOIT**


R.B. B.W. M.L.

County Surveyor.

THE GEO. S. BARRARD COMPANY, ST. LOUIS

**COUNTY BUILDING
IN CITY OF BELOIT**

RESET BY R.B.
B.W.
M.L.

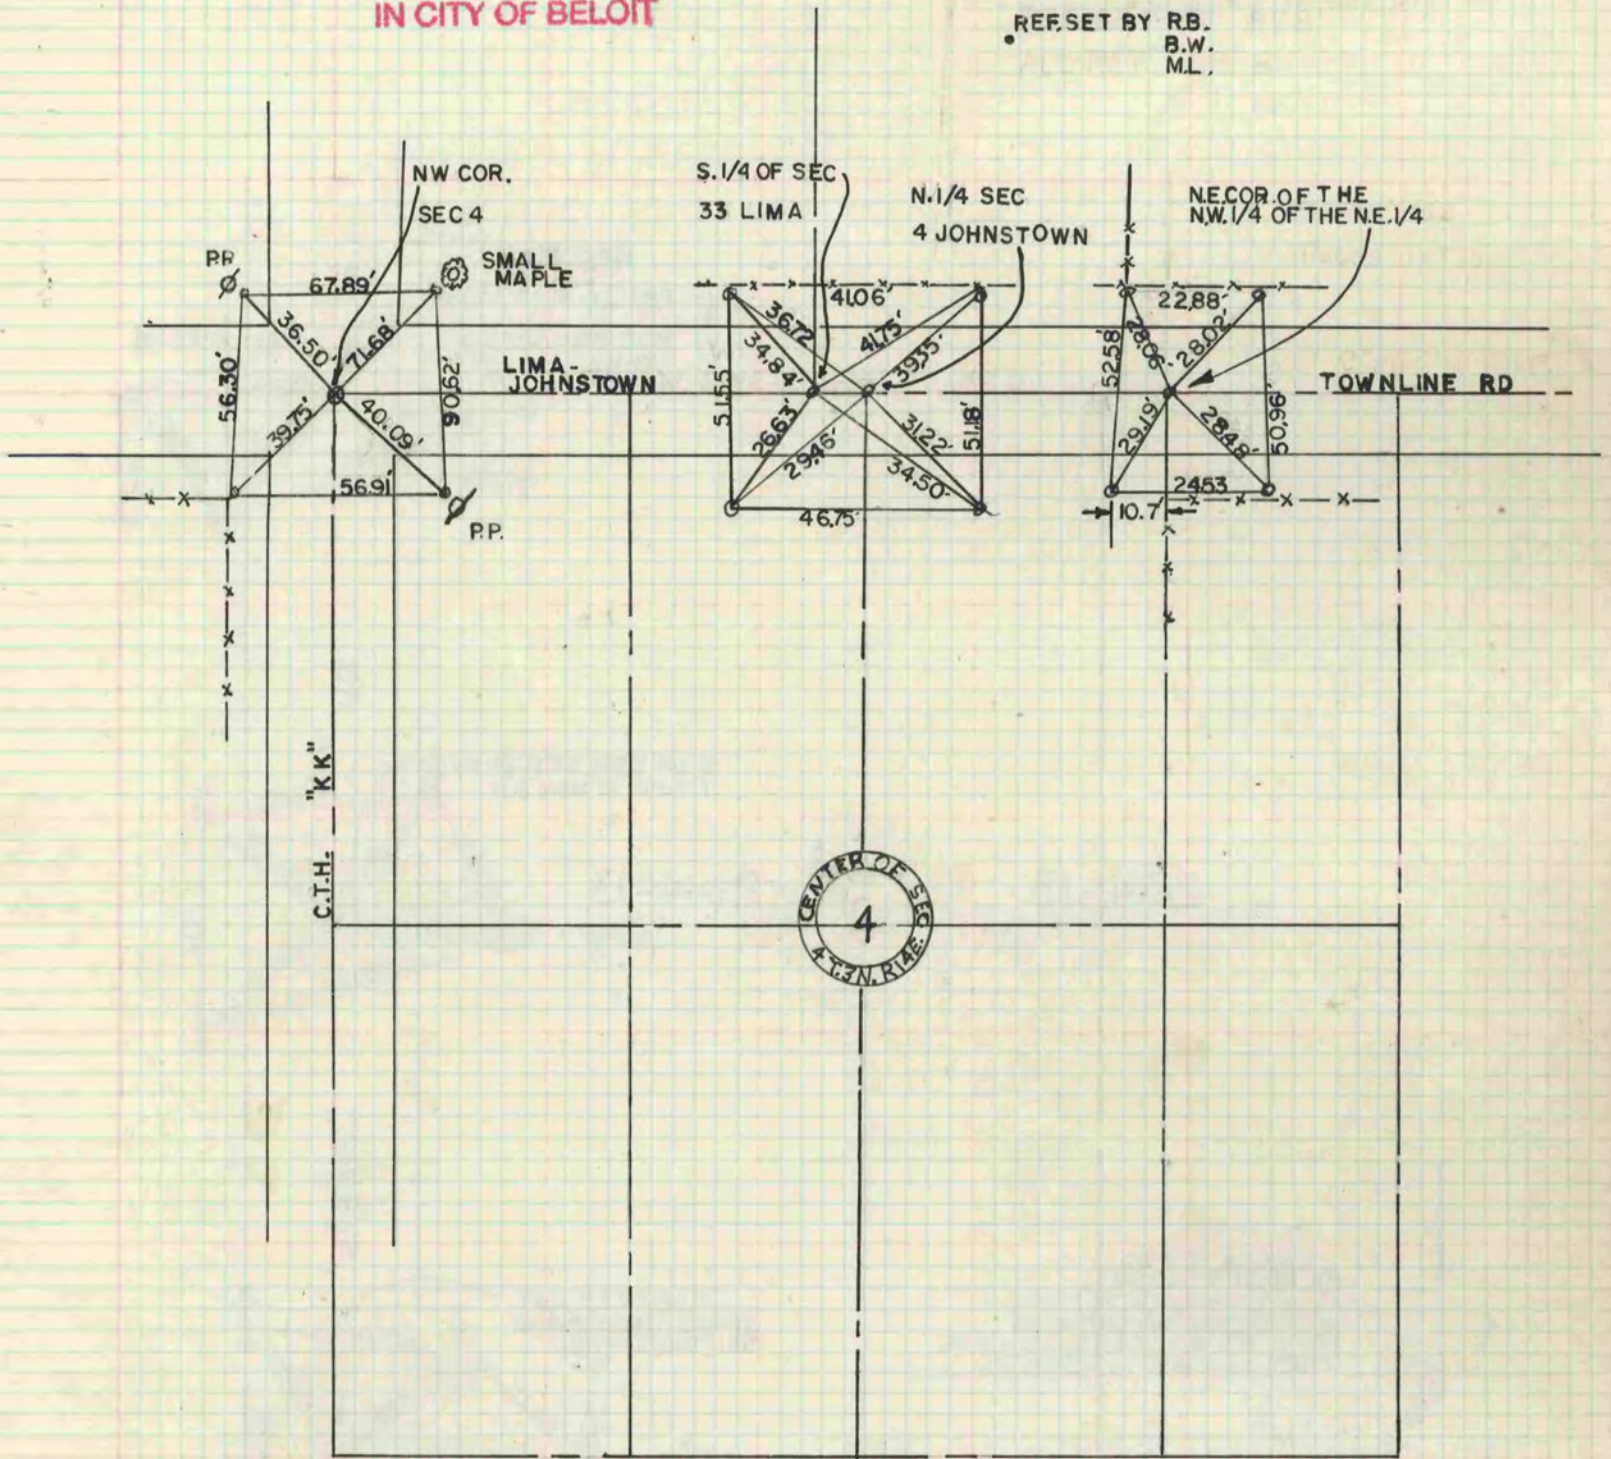

NOTE: \odot = 1" x 24" IRON PIPE

AUGUST 20, 1969

R. B.
B. W.
M. L.

BOOK 152
PAGE 15 & 16

