

PLAT AND RECORD

597


P6 598 JANESVILLE
REC 12/11/75
DAB

Of a Survey on Section 23 T 3 R 14 E. of the 4 P. M. in Johnstown Township

Rock County, Wisconsin, made March the 21 19 73

I hereby certify that the following is a correct record of said survey as made by me.

COUNTY BUILDING
IN CITY OF BELOIT

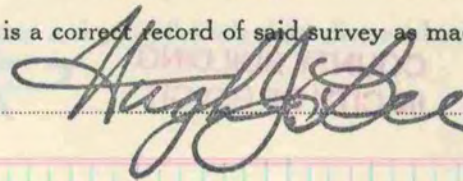

County Surveyor.

THE GEO. D. BARBARO COMPANY, ST. LOUIS

