

PLAT AND RECORD

557


Of a Survey on Section 18 T 1 R 10 E. of the 4 P. M. in Avon Township

Rock County, Wisconsin, made April the 24th 1972

IN CITY OF BELLOIT
COUNTY BUILDING

I hereby certify that the following is a correct record of said survey as made by me.

COUNTY BUILDING
IN CITY OF BELLOIT

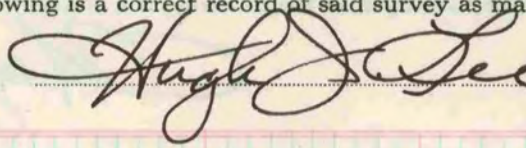

County Surveyor.

THE GEO. S. BARNARD COMPANY, ST. LOUIS

