

# PLAT AND RECORD

553

Of a Survey on Section 8 T 4 R 12 E. of the 4 P. M. in Fulton Township

Rock County, Wisconsin, made April the 17th 19 72


I hereby certify that the following is a correct record of said survey as made by me.

IN CITY OF BELLOIT  
COUNTY BUILDING

COUNTY BUILDING  
IN CITY OF BELLOIT

*Hugh J. De*

County Surveyor.

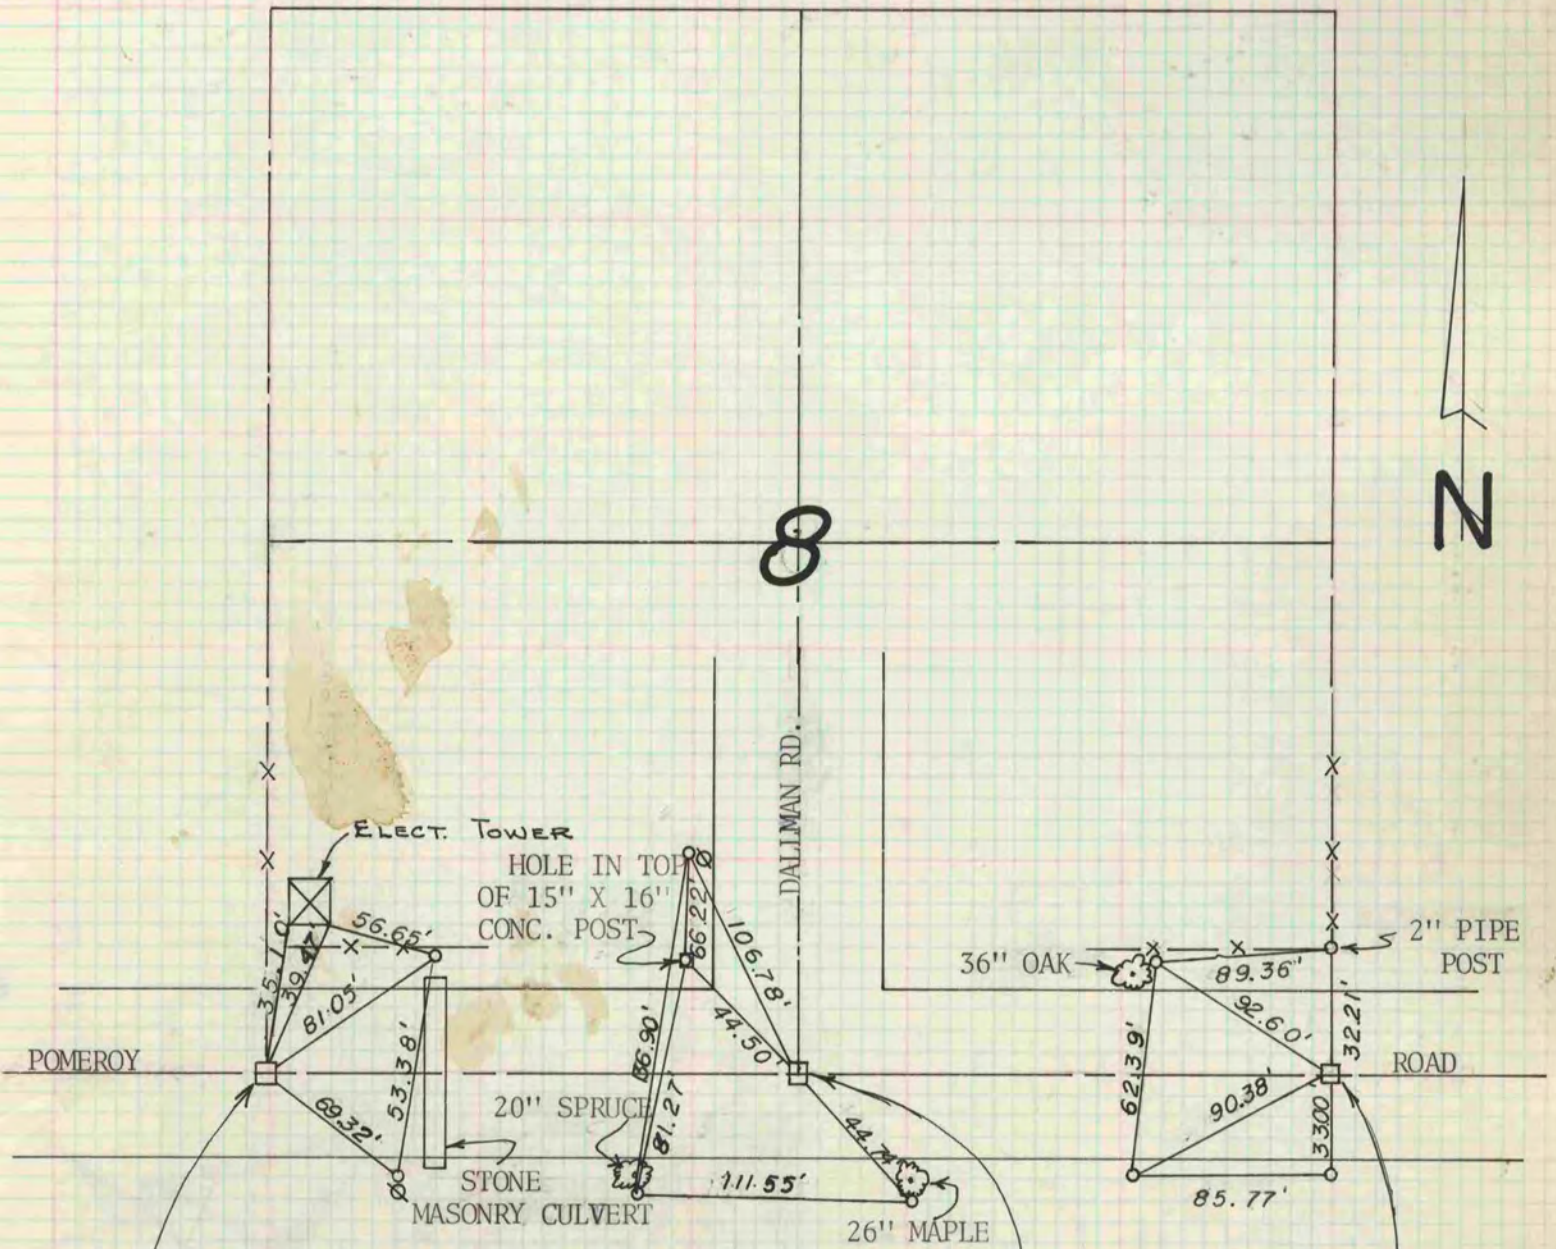

NOTE: ○ = 1" X 24" IRON PIPE REF.

AT S.W. COR. SEC. 8-4-12  
DUG & FND. 2" CAPPED  
PIPE 4" DOWN

S. 1/4 COR. SEC. 8-4-12  
DUG & FND. 2" CAPPED  
PIPE 4" DOWN

S.E. COR. SEC. 8-4-12  
DUG & FND. 2" CAPPED  
PIPE 4" DEEP

J.M.S. - G.B. 4-17-72

J.M.S. - G.B. 4-17-72

J.M.S. - G.B. 4-17-72