

PLAT AND RECORD


Of a Survey on Section ⁸⁻⁹⁻¹⁰ 15-16-17 T 4N R 10 E. of the 4 P. M. in UNION Township
 Rock County, Wisconsin, made JULY 23 to the 31 1957

I hereby certify that the following is a correct record of said survey as made by me.

COUNTY BUILDING
 IN CITY OF BELOIT

Richard A. Batterman

County Surveyor.

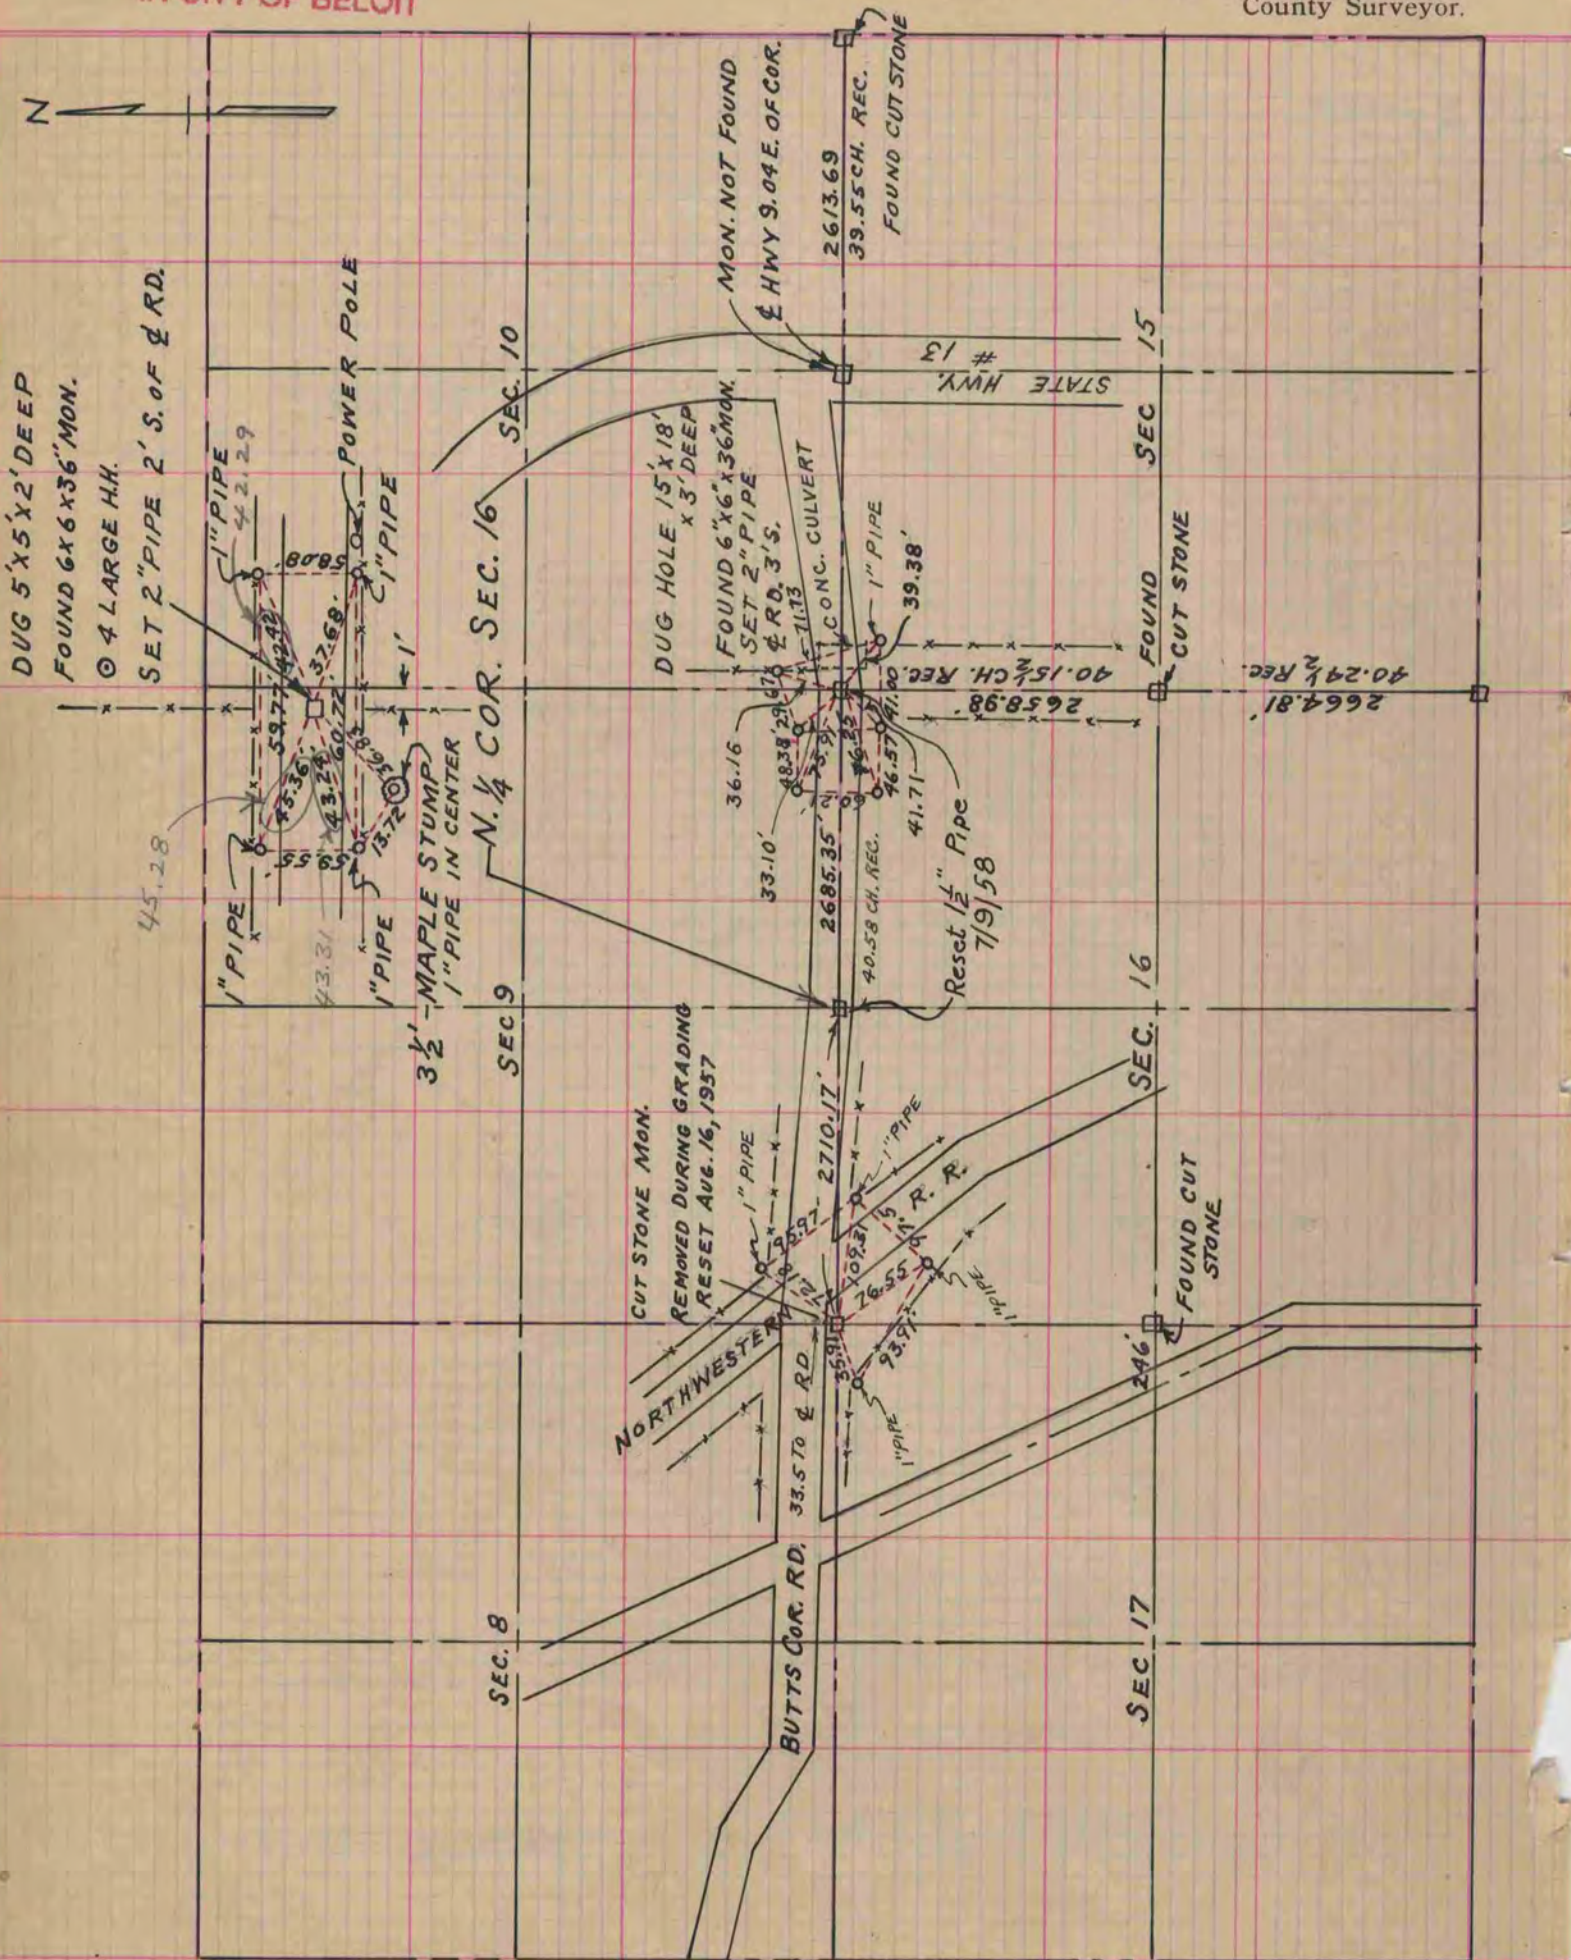

FIELD WORK BY THE FOLLOWING:

- S. CUSHMAN
- D. BATTERMAN III
- T. KERWIN
- J. GREEN