

PLAT AND RECORD

165

PG 186 JANESVILLE
REC 12/12/75 DAB

Of a Survey on Section 20 + 29 T 1 R 13 E. of the 4 P. M. in Turtle Township


Rock County, Wisconsin, made November the 24th 1930

I hereby certify that the following is a correct record of said survey as made by me.

RAB.

County Surveyor.

COUNTY BUILDING
IN CITY OF БЕЛОIT

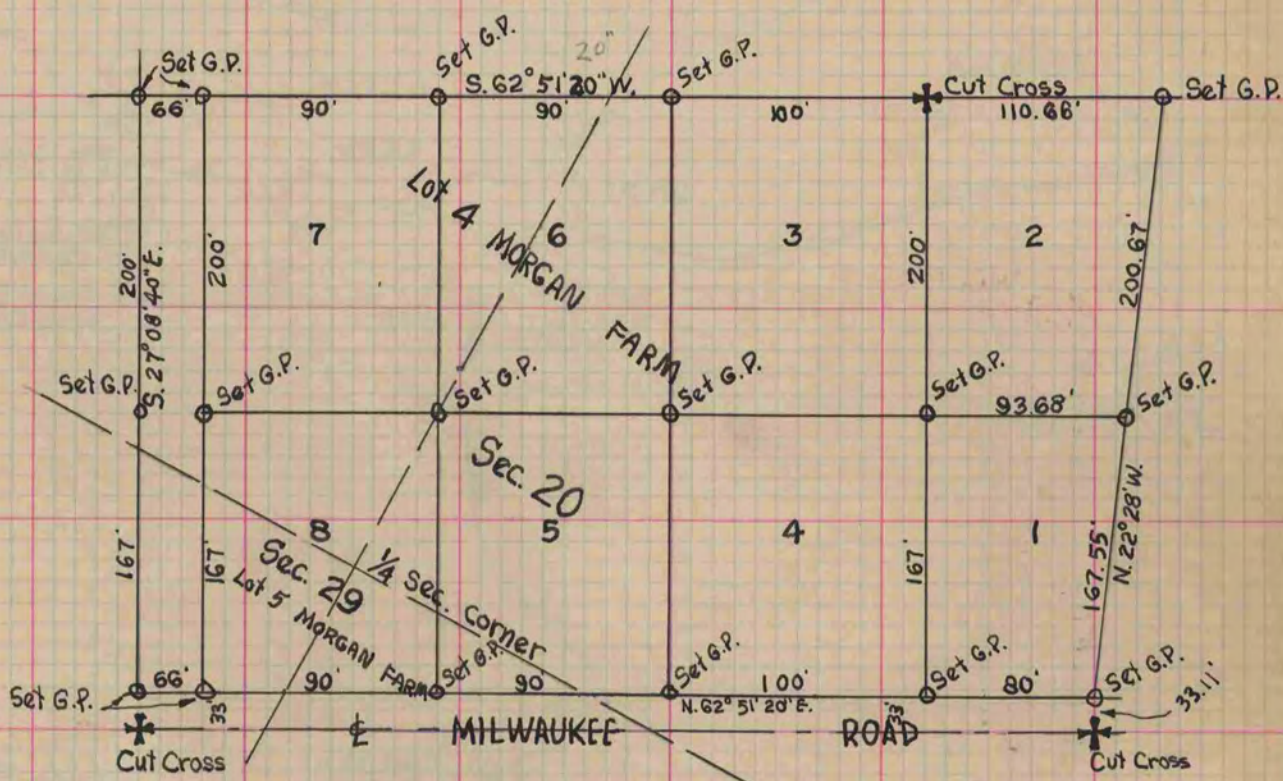

Order # 1831