

156 PLAT AND RECORD

PG 175 JANESVILLE
REC 12/12/75 DAB


Of a Survey on Section 26-27 T 1 R 11 E. of the 4 P. M. in Newark Township
Rock County, Wisconsin, made April the 5th 1930

I hereby certify that the following is a correct record of said survey as made by me.

R A B.

COUNTY BUILDING
IN CITY OF BELLOIT

County Surveyor.

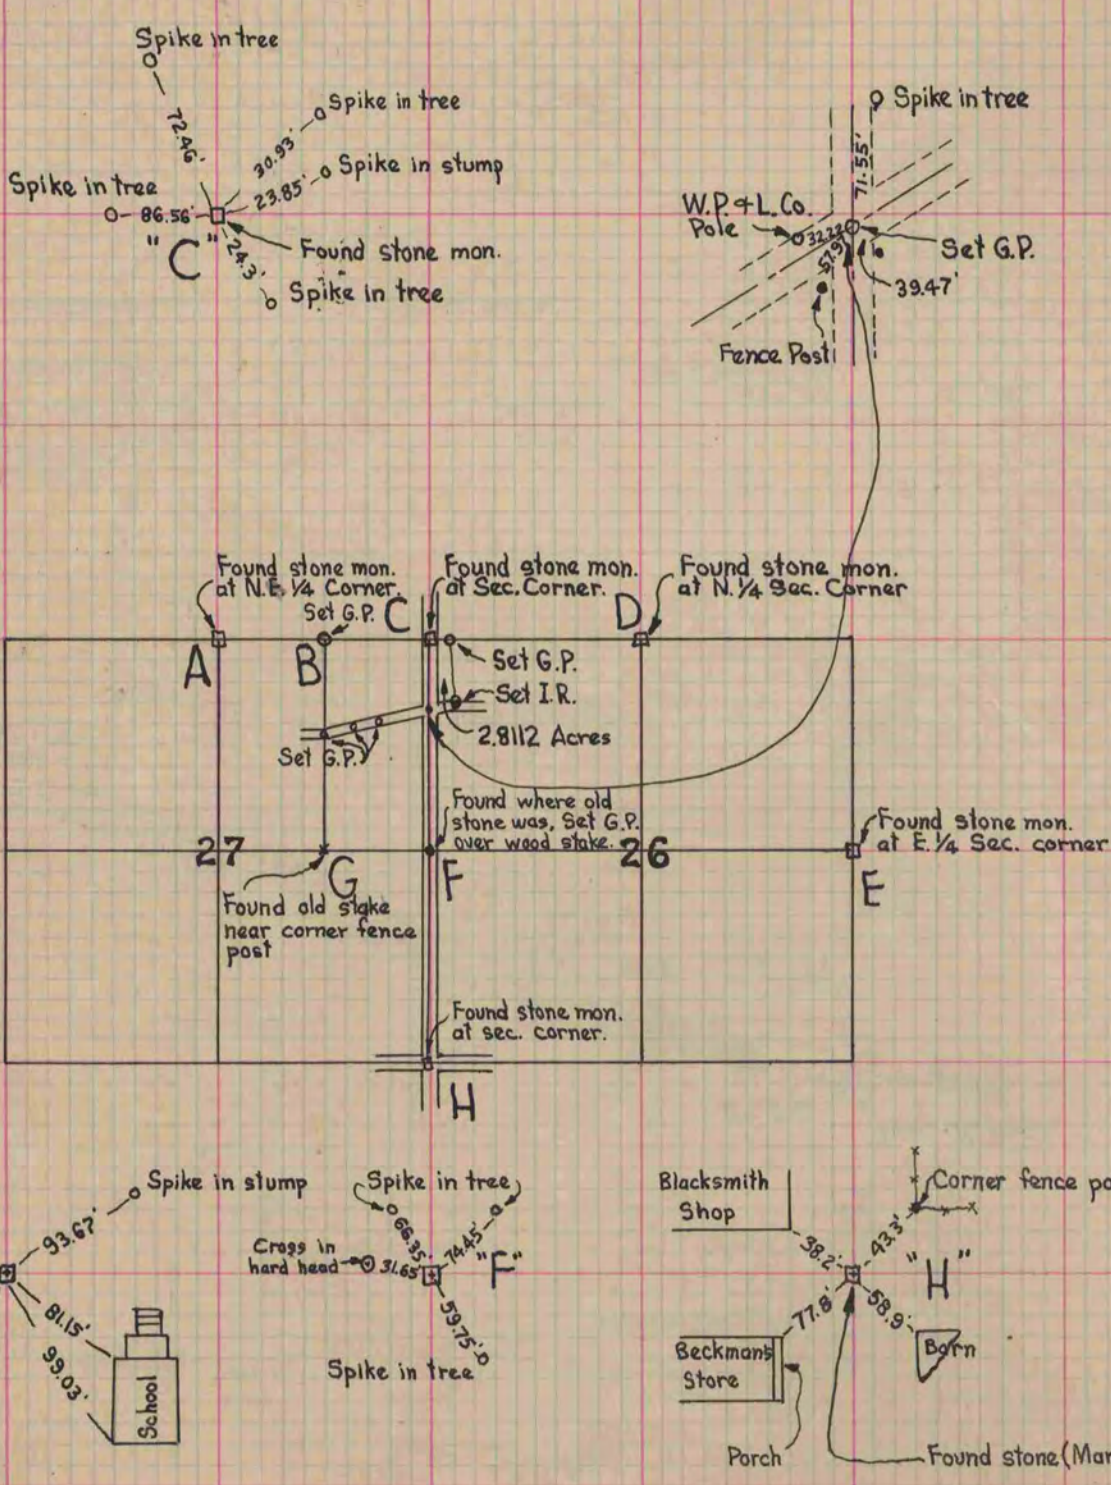

Order # 1750