

# PLAT AND RECORD

567

Of a Survey on Section 23 T 4N R 11 E. of the 4 P. M. in Porter Township  
Rock County, Wisconsin, made October the 20<sup>th</sup> 19 58


I hereby certify that the following is a correct record of said survey as made by me.

COUNTY BUILDING  
IN CITY OF BELOIT

SEE Pg 293 VOLUME 2

County Surveyor.

SCALE 1"=80'

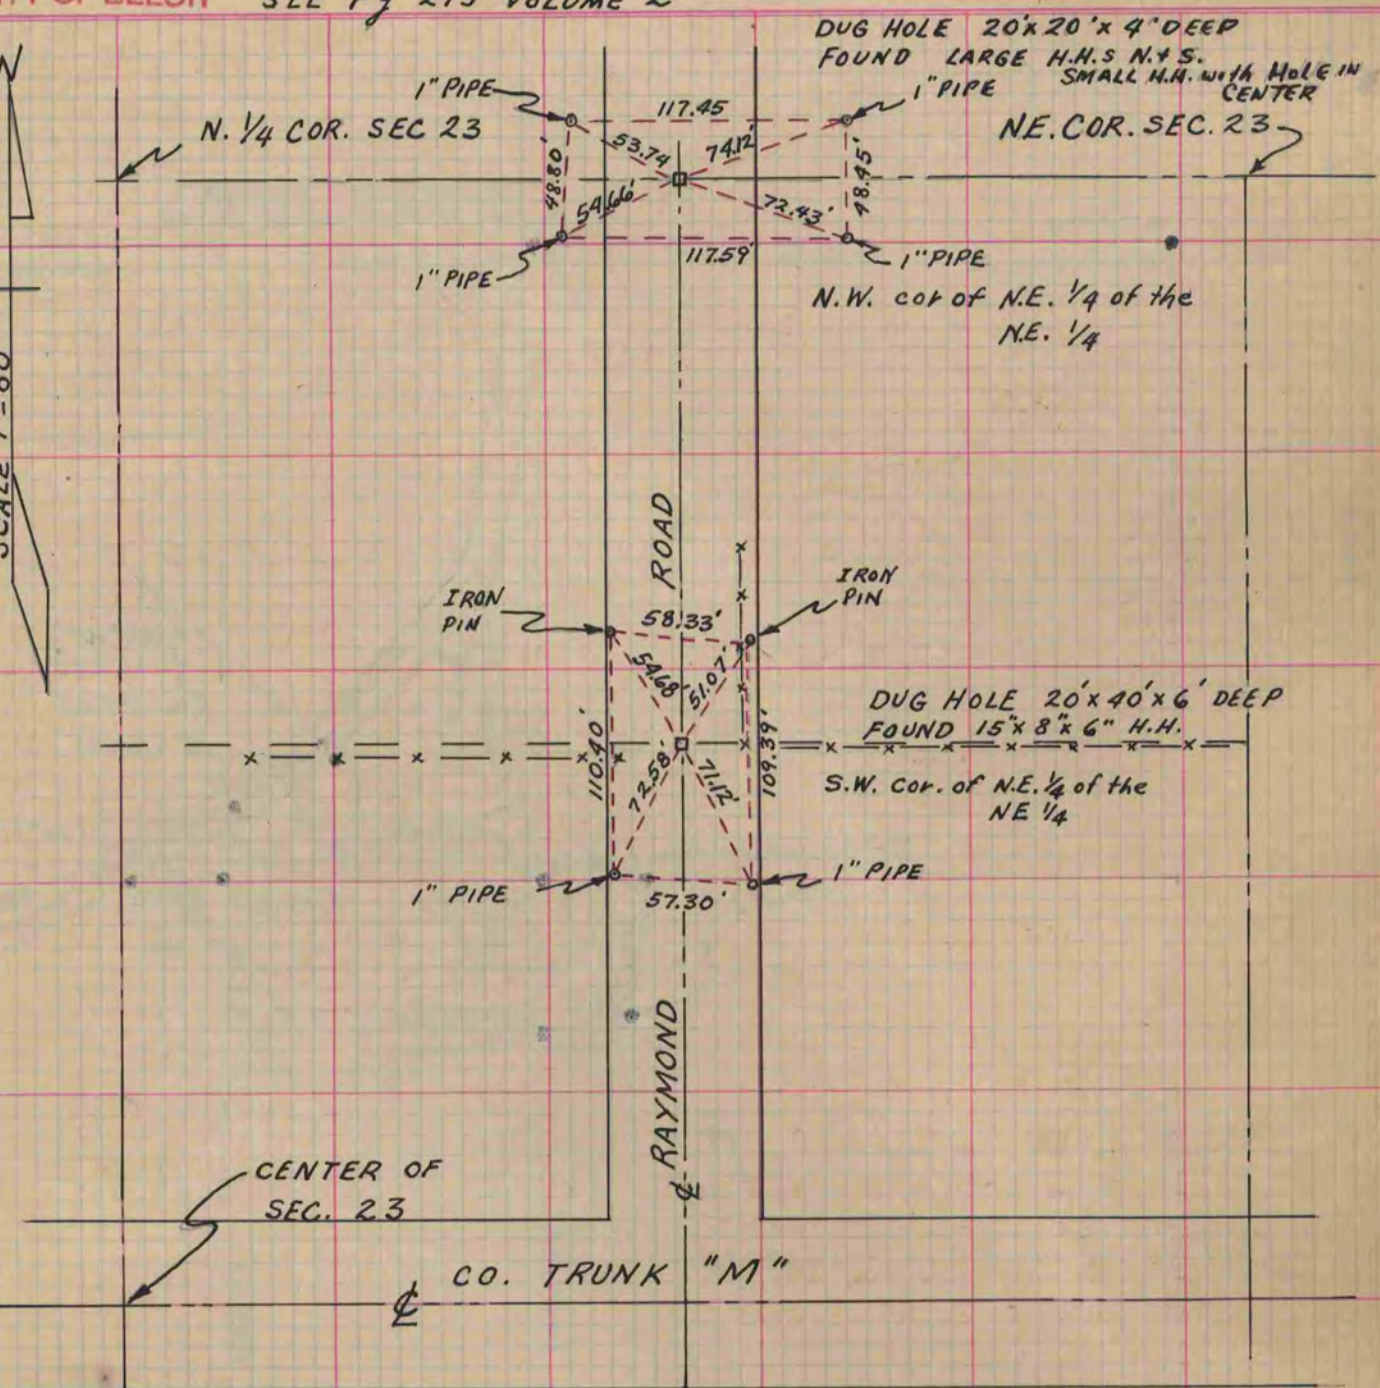

WORK DONE BY  
T. DOLL  
L. MCKAY  
J. GREEN

VOID