

PLAT AND RECORD

Of a Survey on Section 14 T 2 R 10 E. of the 4 P. M. in SPRING VALLEY Township

Rock County, Wisconsin, made AUG. the 17th. 1964

I hereby certify that the following is a correct record of said survey as made by me.

Robbatten

County Surveyor.

N

M. Hoff
T. Kerwin

COUNTY BUILDING
IN CITY OF BELOIT


SEE PAGE 392, VOL. 4

SEE PG. 360, VOL. 4

14

Dug hole 12'x9'x4'
at the S.W.X. Sec.
14-2-10 found
nothing.

OLD

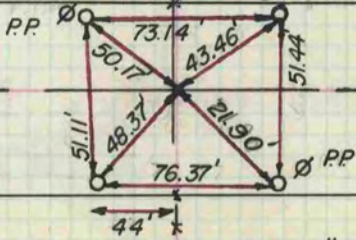

HIGHWAY

20

Found 1" Sq. iron ROD surr. by
3 H.H. at the S.1/4 cor Sec.
14-2-10.