

# PLAT AND RECORD

Of a Survey on Section 10 T 1 R 10 E. of the 4 P. M. in Avon Township


Rock County, Wisconsin, made June the 25, 26 & 27 1874

I hereby certify that the following is a correct record of said survey as made by me.

COUNTY BUILDING  
IN CITY OF БЕЛОИТ

(Signed) Edward Ruger  
P.M.A.

County Surveyor.

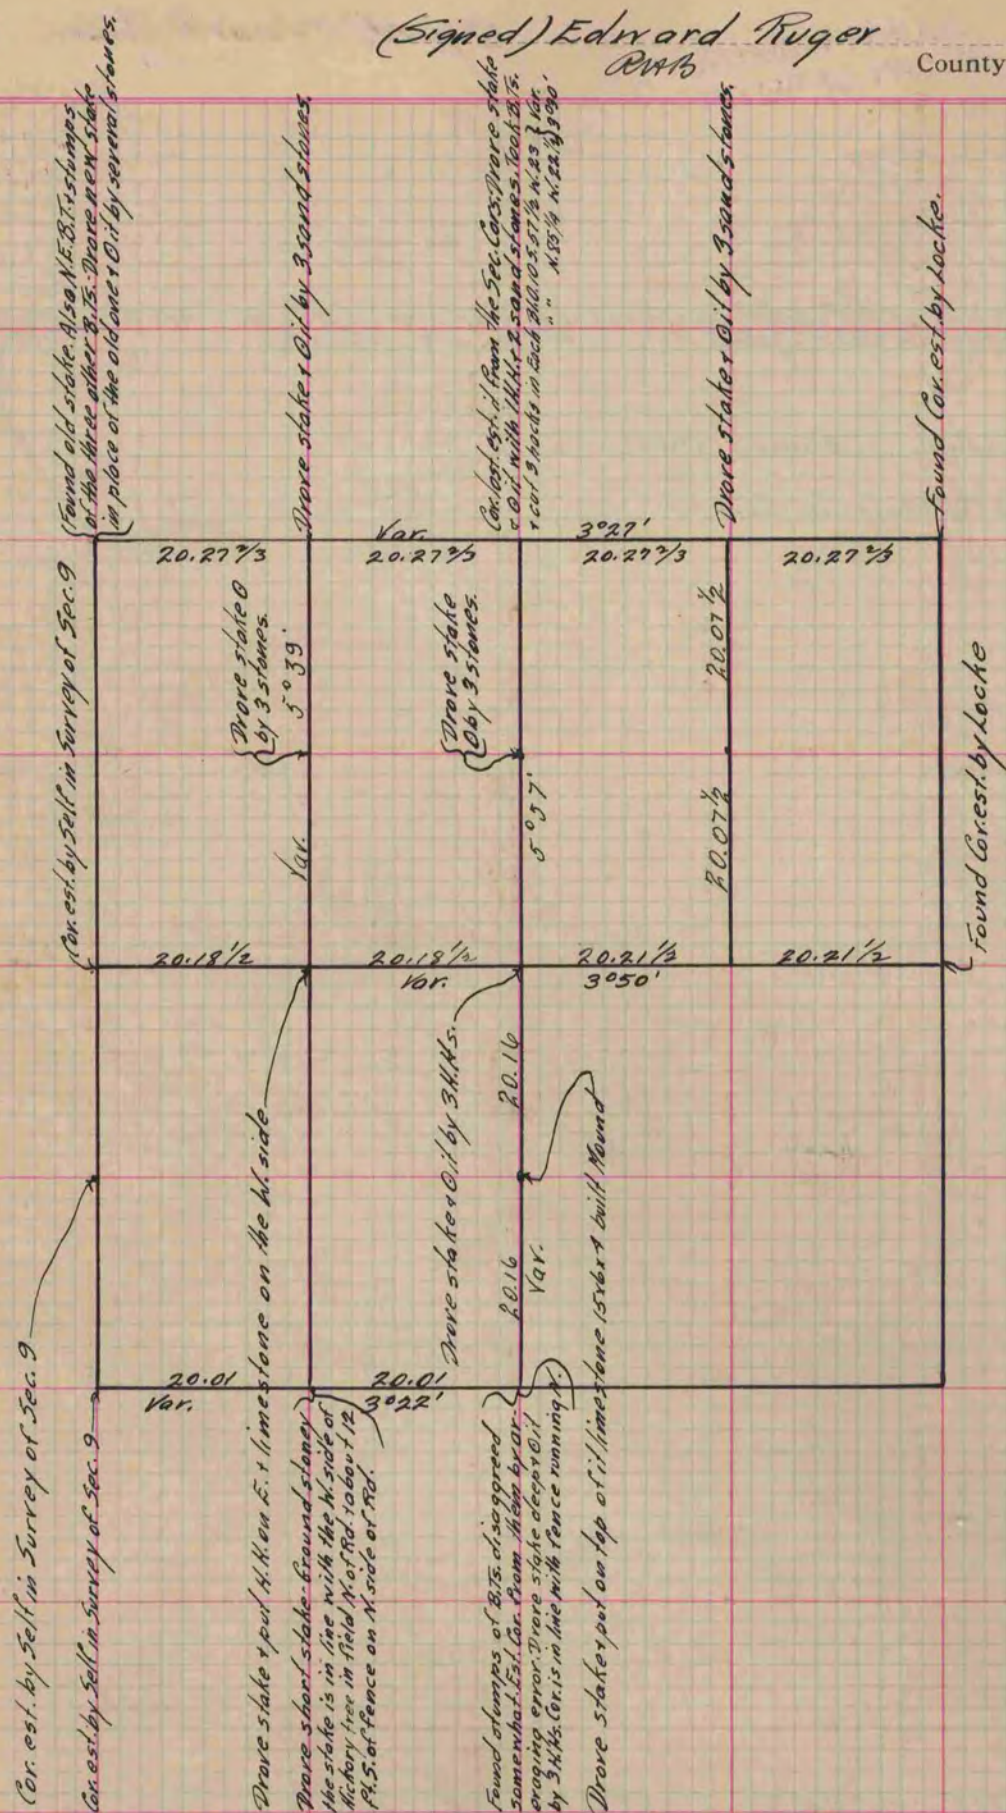

Copied from P. 103 Vol. 2 Original County Surveyor's Record.