

PLAT AND RECORD

461


Of a Survey on Section 21 T 4 R 13 E. of the 4 P. M. in Milton Township

Rock County, Wisconsin, made Feb. the 24th 1892

I hereby certify that the following is a correct record of said survey as made by me.

COUNTY BUILDING
IN CITY OF BELOIT

(Signed) O. G. Bleckorn
O. G. B. Dep. County Surveyor.

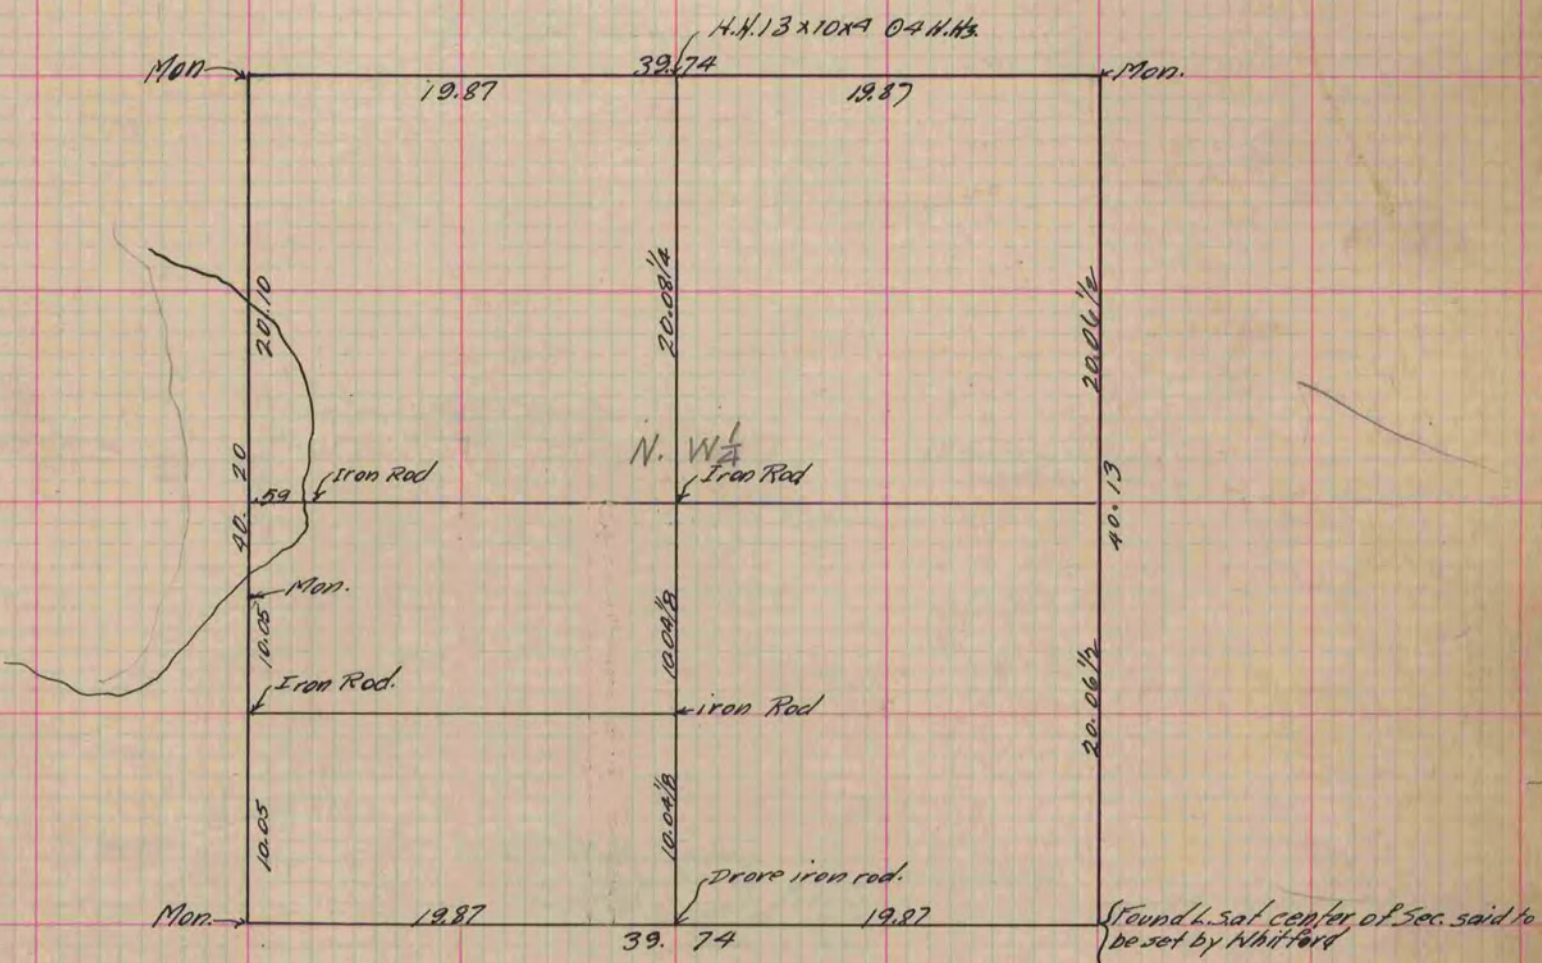

Copied from P. 364 Vol. 2 County Surveyor's Record.