

PLAT AND RECORD


Of a Survey on Section 17 T A R 11 E. of the 4 P. M. in Porter Township
Rock County, Wisconsin, made Aug. the 15 1895

I hereby certify that the following is a correct record of said survey as made by me.

COUNTY BUILDING
IN CITY OF БЕЛОIT

(Signed) P.F. Brown
P.M.S.

County Surveyor.

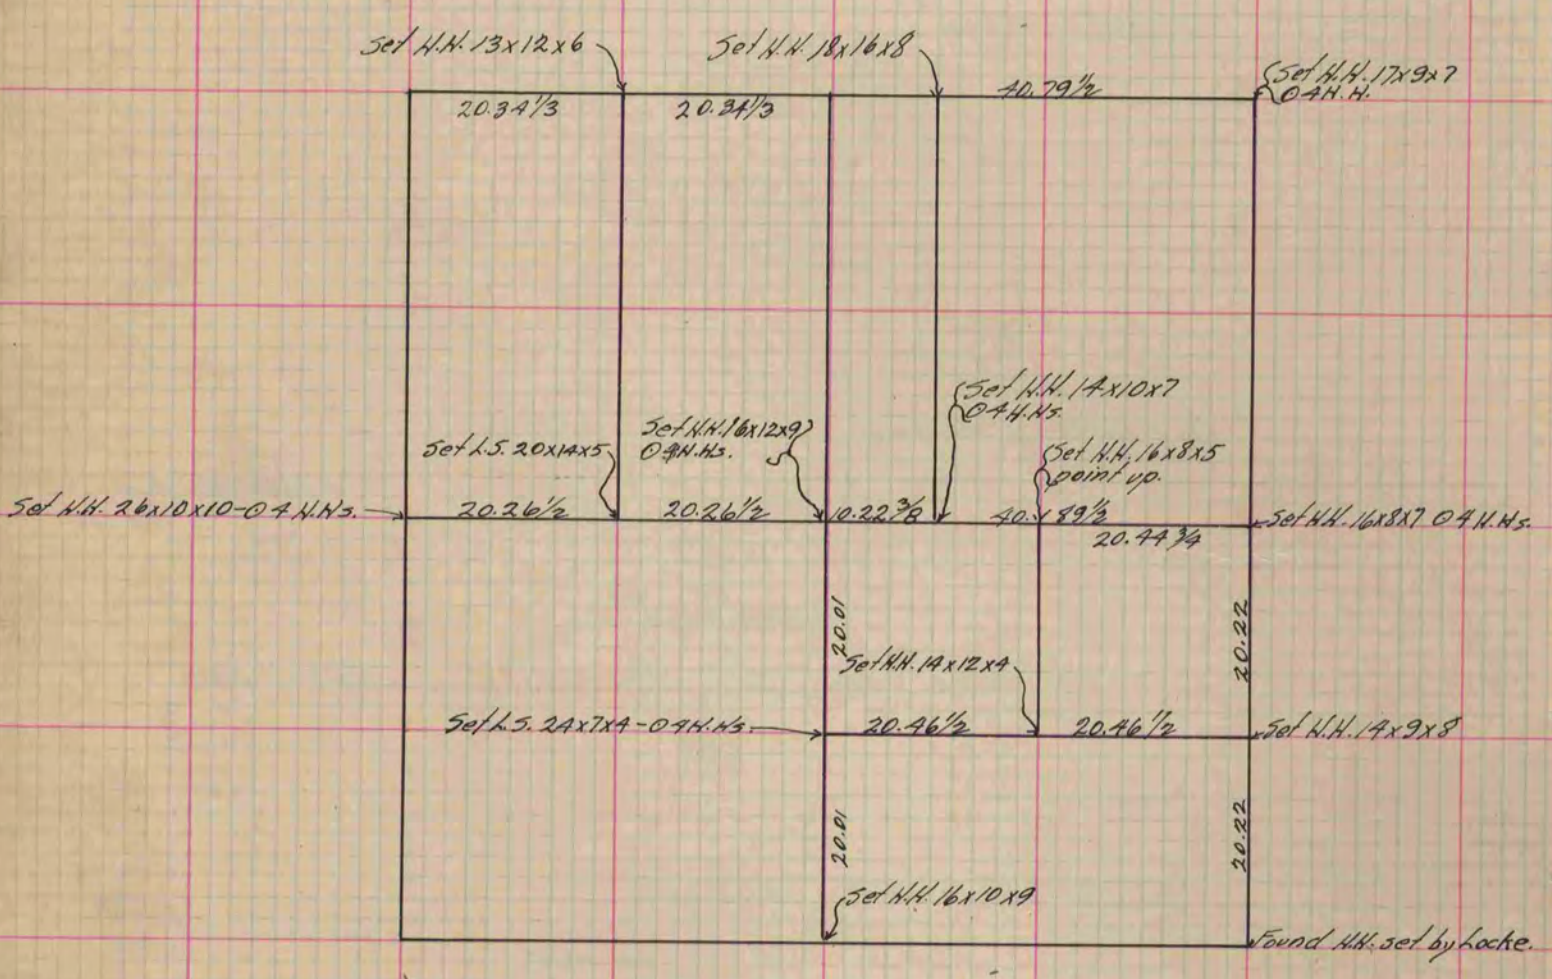

Copied from P. 381 Vol. 2 County Surveyor's Record.