

PLAT AND RECORD

Of a Survey on Section 11 T 1 R 13 E. of the 4 P. M. in Turtle Township

Rock County, Wisconsin, made January the 10 1882


I hereby certify that the following is a correct record of said survey as made by me.

COUNTY BUILDING
IN CITY OF BELOIT

(Signed) S. F. Holmes.
S.F.H.

County Surveyor.

Sec. 11 Turtle

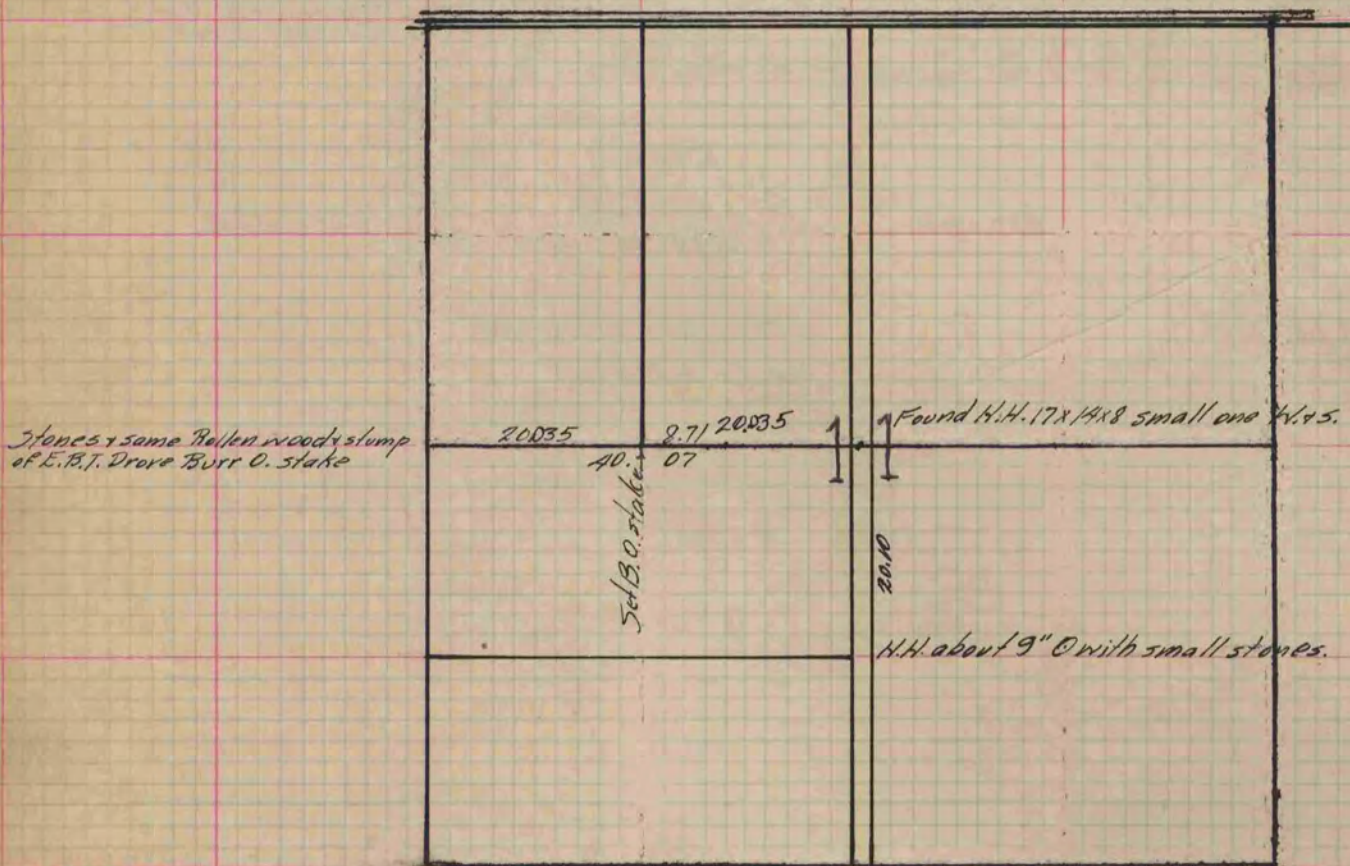

This survey was made at the request of W.H. Lathers to determine the S. line of E. 1/2 of N.W. 1/4 & from the stake set to indicate the line only. Westerly the fence is all N; the nearest post being 12 to 18 inches N. of line.

Copied from P. 281 Vol. 2 County Surveyor's Record.