


PLAT AND RECORD

Of a Survey on Section 5 T 3 R 10 E. of the 4 P. M. in Magndia Township
Rock County, Wisconsin, made Oct. the 23 1890

I hereby certify that the following is a correct record of said survey as made by me.

COUNTY BUILDING
IN CITY OF BELOIT

(Signed) O.G. Bleedorn
O.G.B. Dept. County Surveyor.

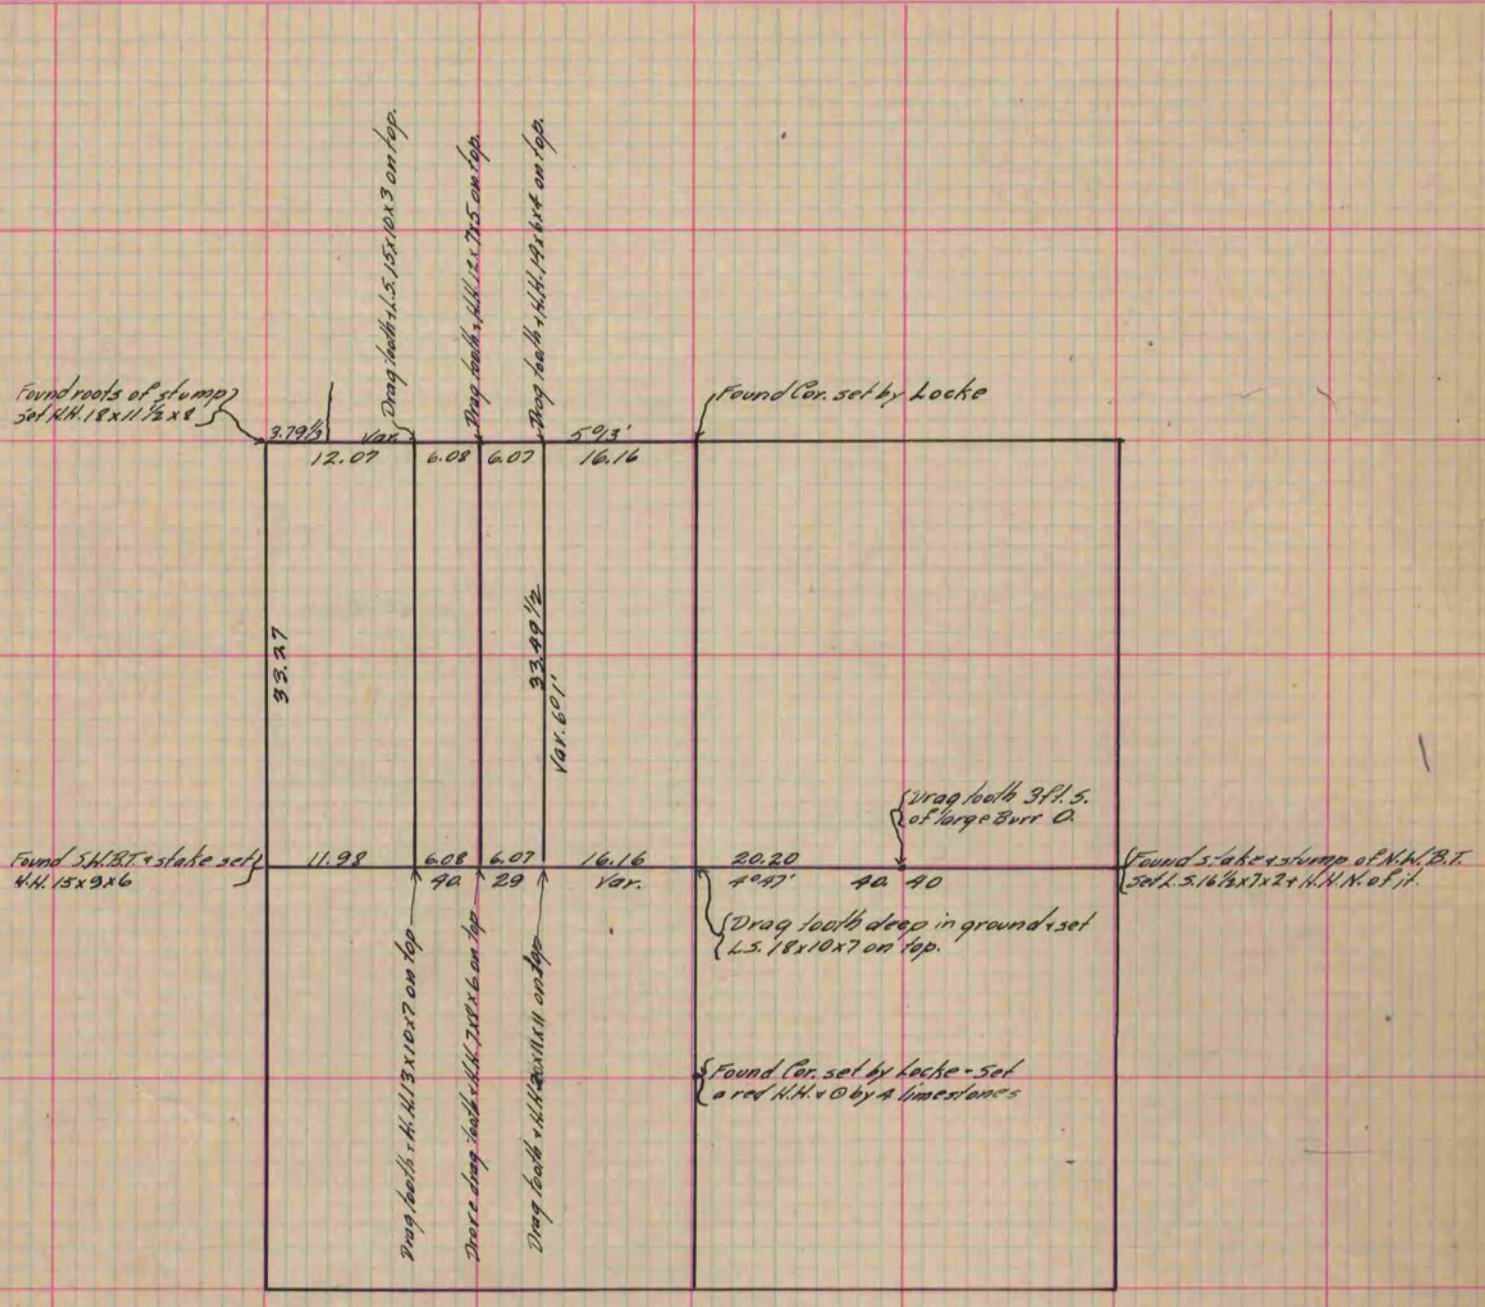

Copied from P. 952 Vol. 2 County Surveyor's Record.