

PLAT AND RECORD

239

Of a Survey on Section 29 T 1 R 14 E. of the 4 P. M. in CLINTON Township

Rock County, Wisconsin, made NOV. the 16th 1965


I hereby certify that the following is a correct record of said survey as made by me.

COUNTY BUILDING
IN CITY OF БЕЛОIT

R. B. [Signature]

County Surveyor.

THE GEO. S. BARNARD COMPANY, ST. LOUIS

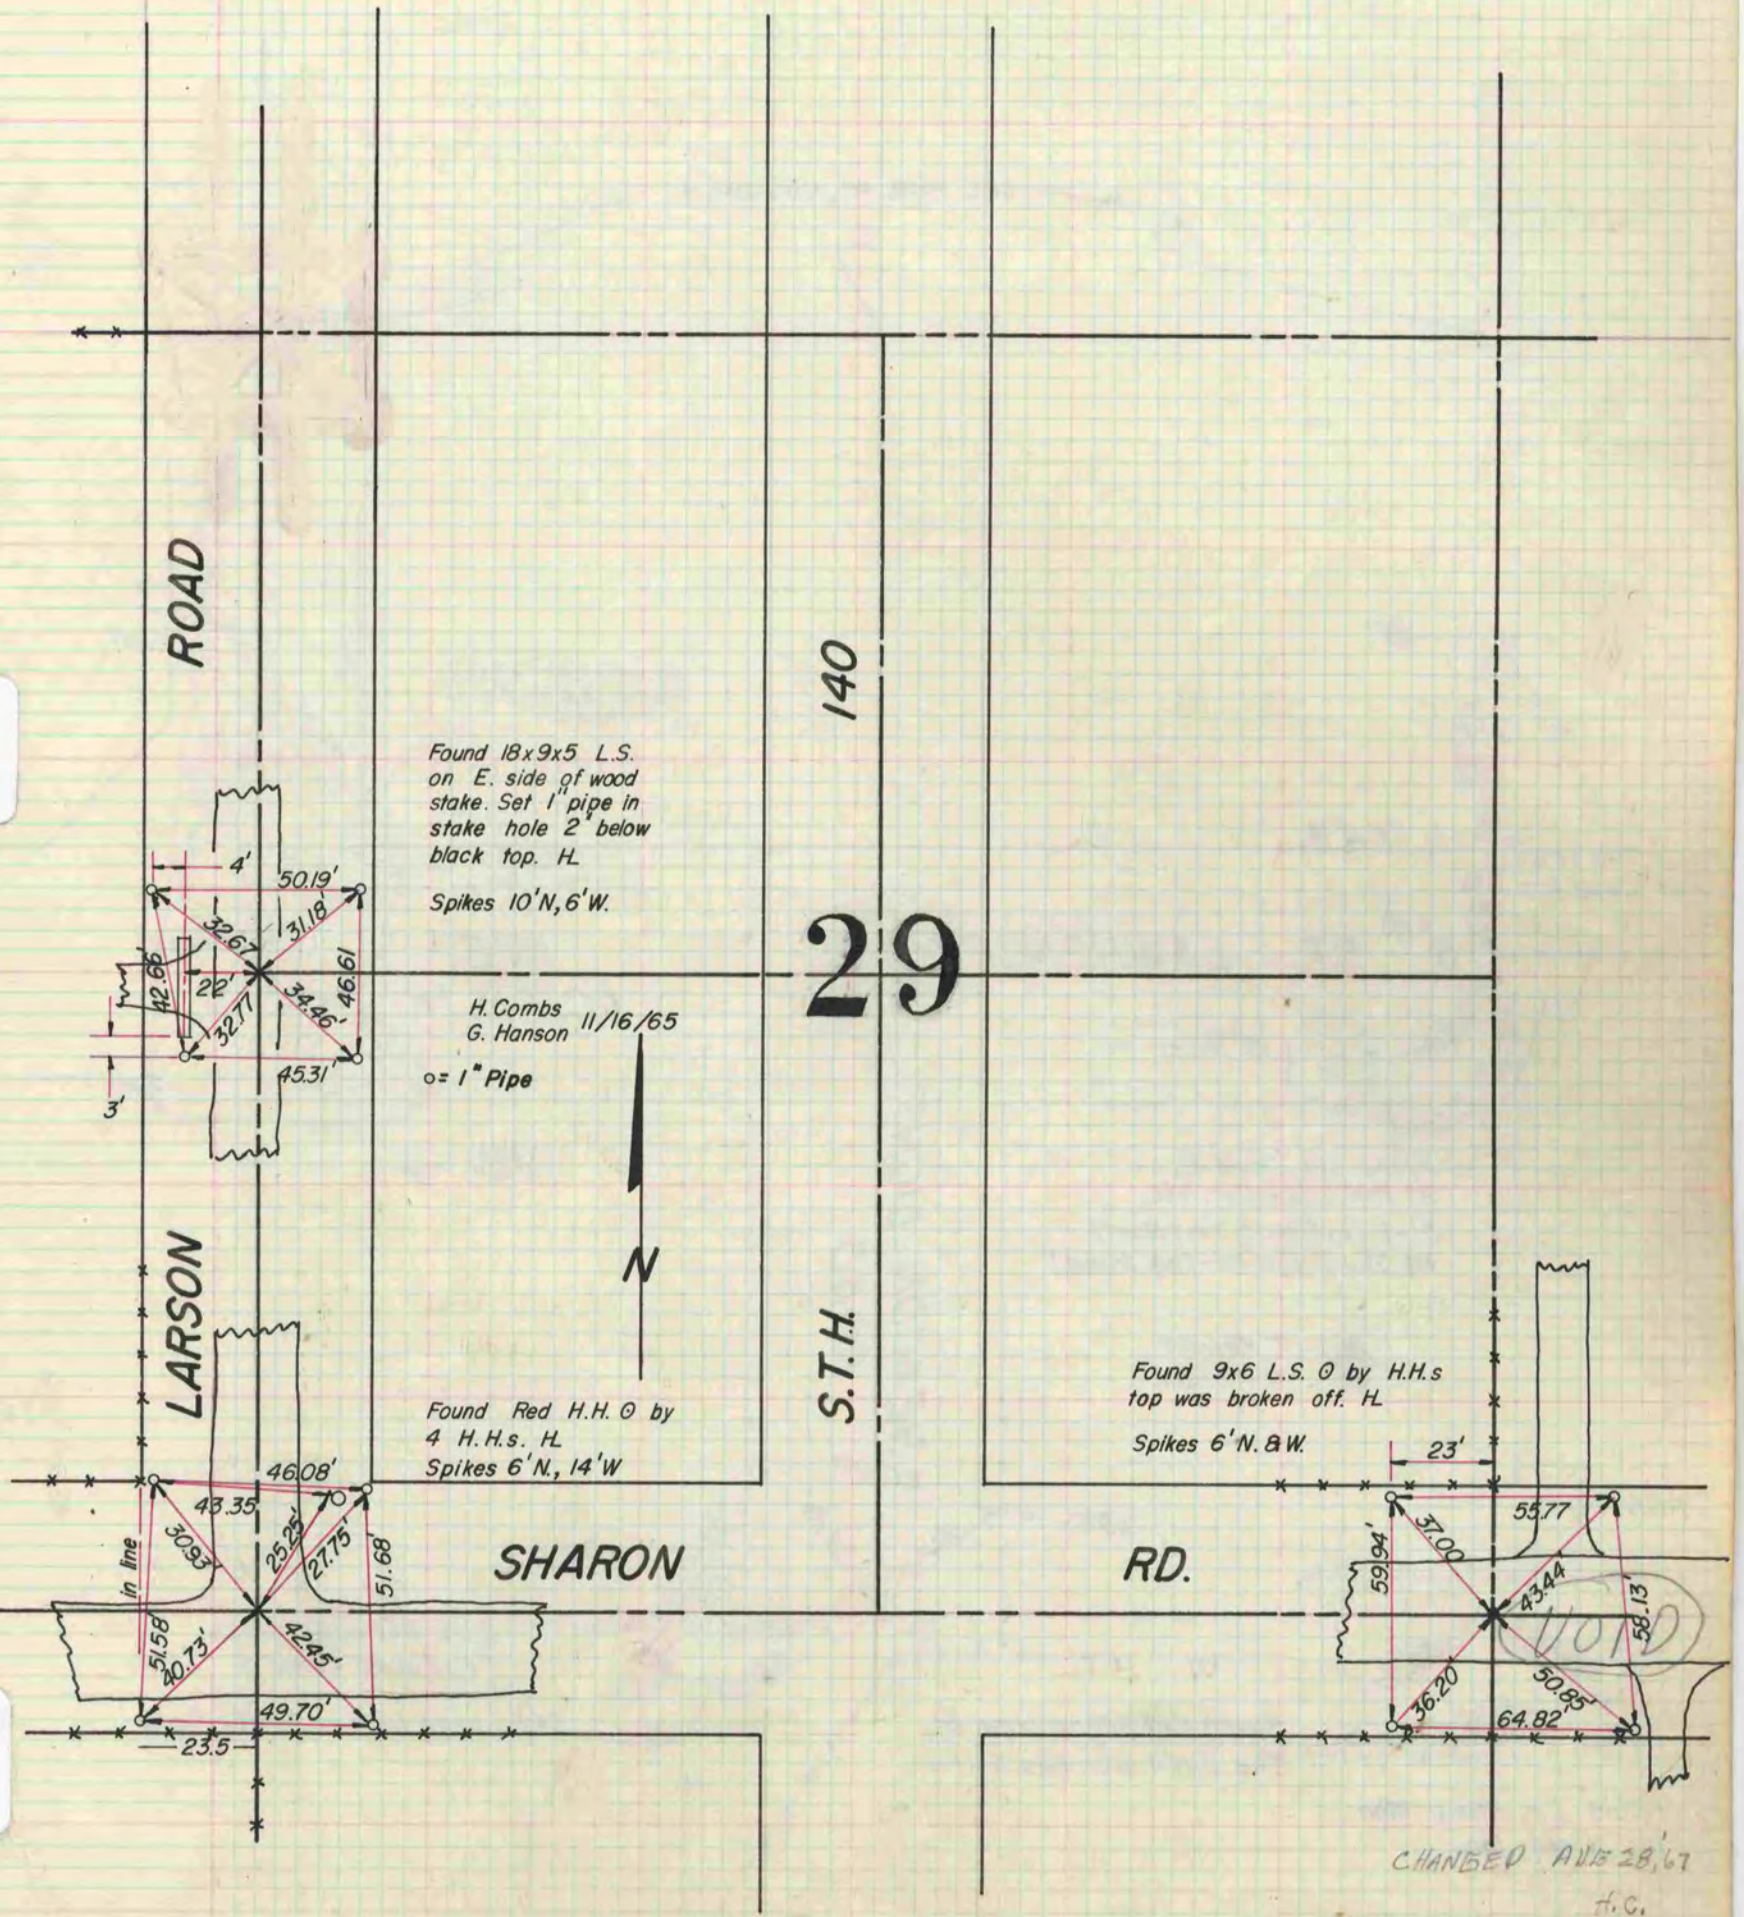

CHANGED AUG 28, 67
H.C.
O.S.
CANNOT FIND ANY
OTHER RECORD
OF THE CHANGE
BW 5125113