

# PLAT AND RECORD

Of a Survey on Section 11 T 1 R 11 E. of the 4 P. M. in Newark Township  
Rock County, Wisconsin, made January the 5<sup>th</sup> 1882


I hereby certify that the following is a correct record of said survey as made by me.

COUNTY BUILDING  
IN CITY OF БЕЛОИТ

(Signed) J. F. Holmes  
JFH

County Surveyor.

N.W. 1/4 Sec. 11 Newark

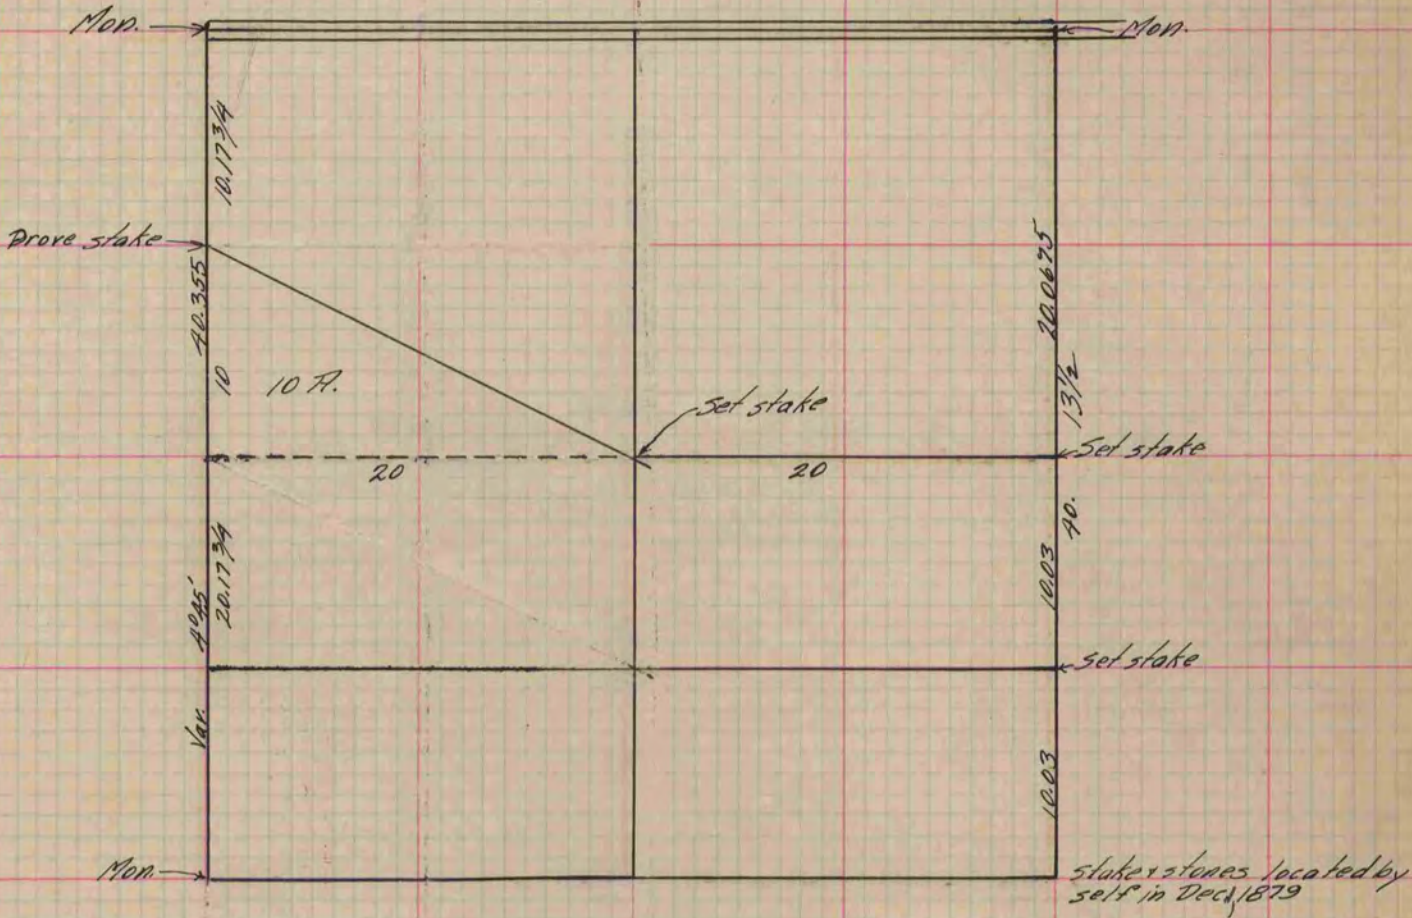

Copied from P. 282 Vol. 2 County Surveyor's Record.