


PLAT AND RECORD

Of a Survey on ^{SE 1/4} Section 10 T 3 R 13 E. of the 4 P. M. in Harmony Township
 Rock County, Wisconsin, made Nov. the 5 1890

I hereby certify that the following is a correct record of said survey as made by me.

COUNTY BUILDING
 IN CITY OF БЕЛОIT

(Signed) O. G. Bleedorn
 O.G.B. Dep. County Surveyor.

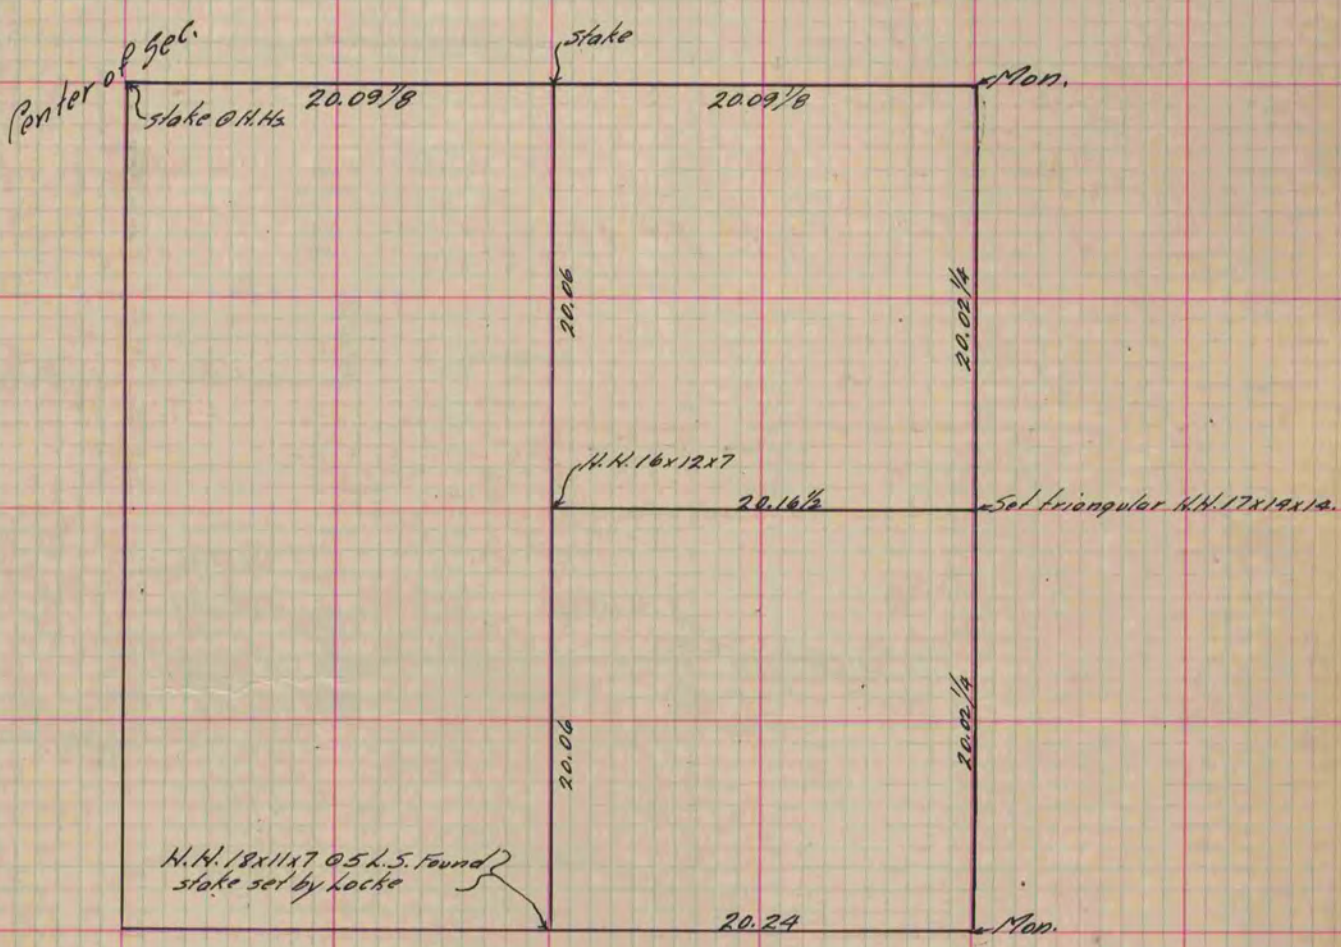

Copied from P. 350 County Surveyor's Record.