

PLAT AND RECORD


Of a Survey on Section 6 T. 4 R. 11 E. of the 4 P. M. in Porter Township
Rock County, Wisconsin, made March the 23rd 1898

I hereby certify that the following is a correct record of said survey as made by me.

COUNTY BUILDING
IN CITY OF BELOIT

(Signed) O. G. Bledorn
O. G. Bledorn

County Surveyor.

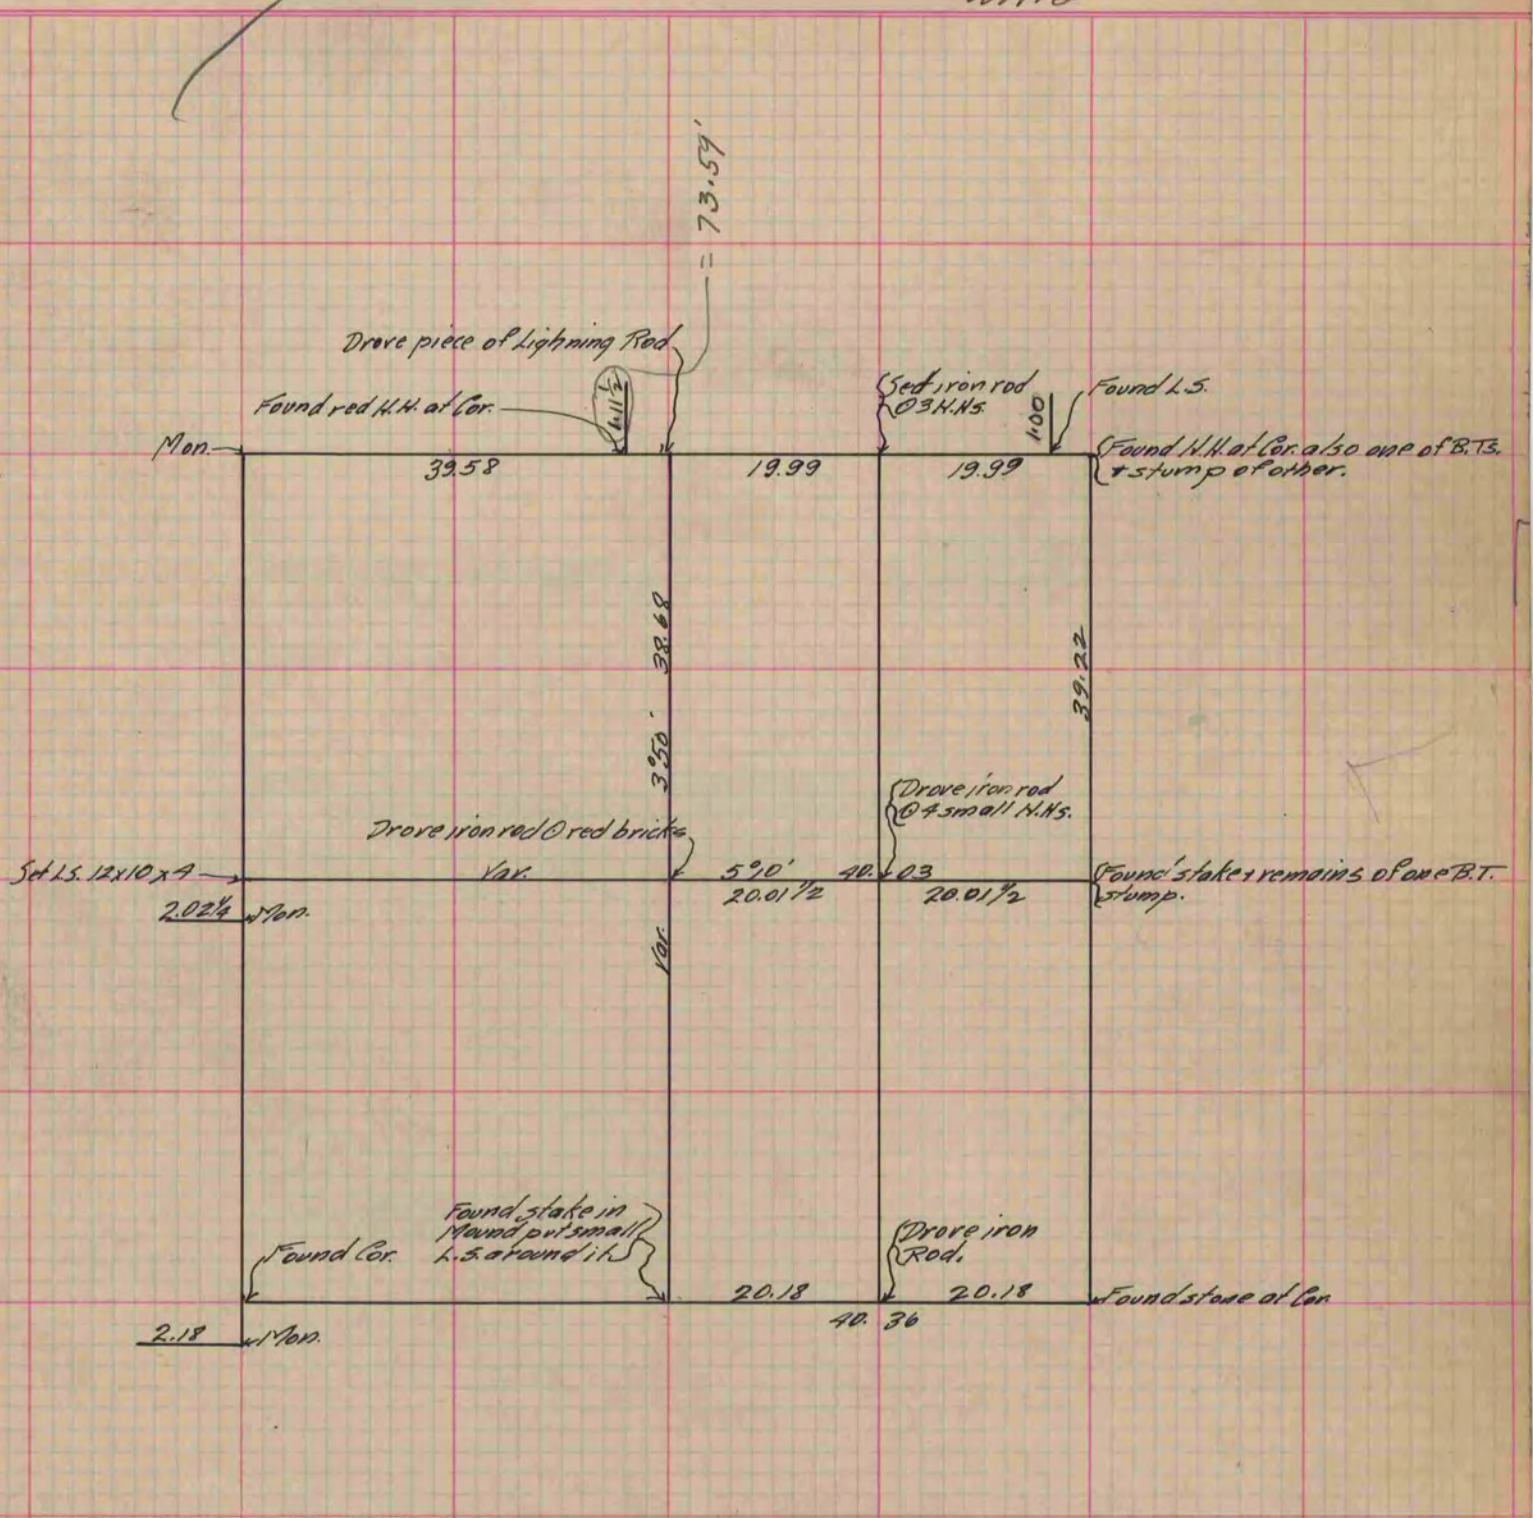

Copied from P. 370 Vol. 2 County Surveyor's Record.