

PLAT AND RECORD

Of a Survey on Section 6 T 3 R 12 E. of the 4 P. M. in Sanesville Township


Rock County, Wisconsin, made July the 10 1873

I hereby certify that the following is a correct record of said survey as made by me.

COUNTY BUILDING
IN CITY OF БЕЛОIT

(Signed) Edward Ruger

County Surveyor.

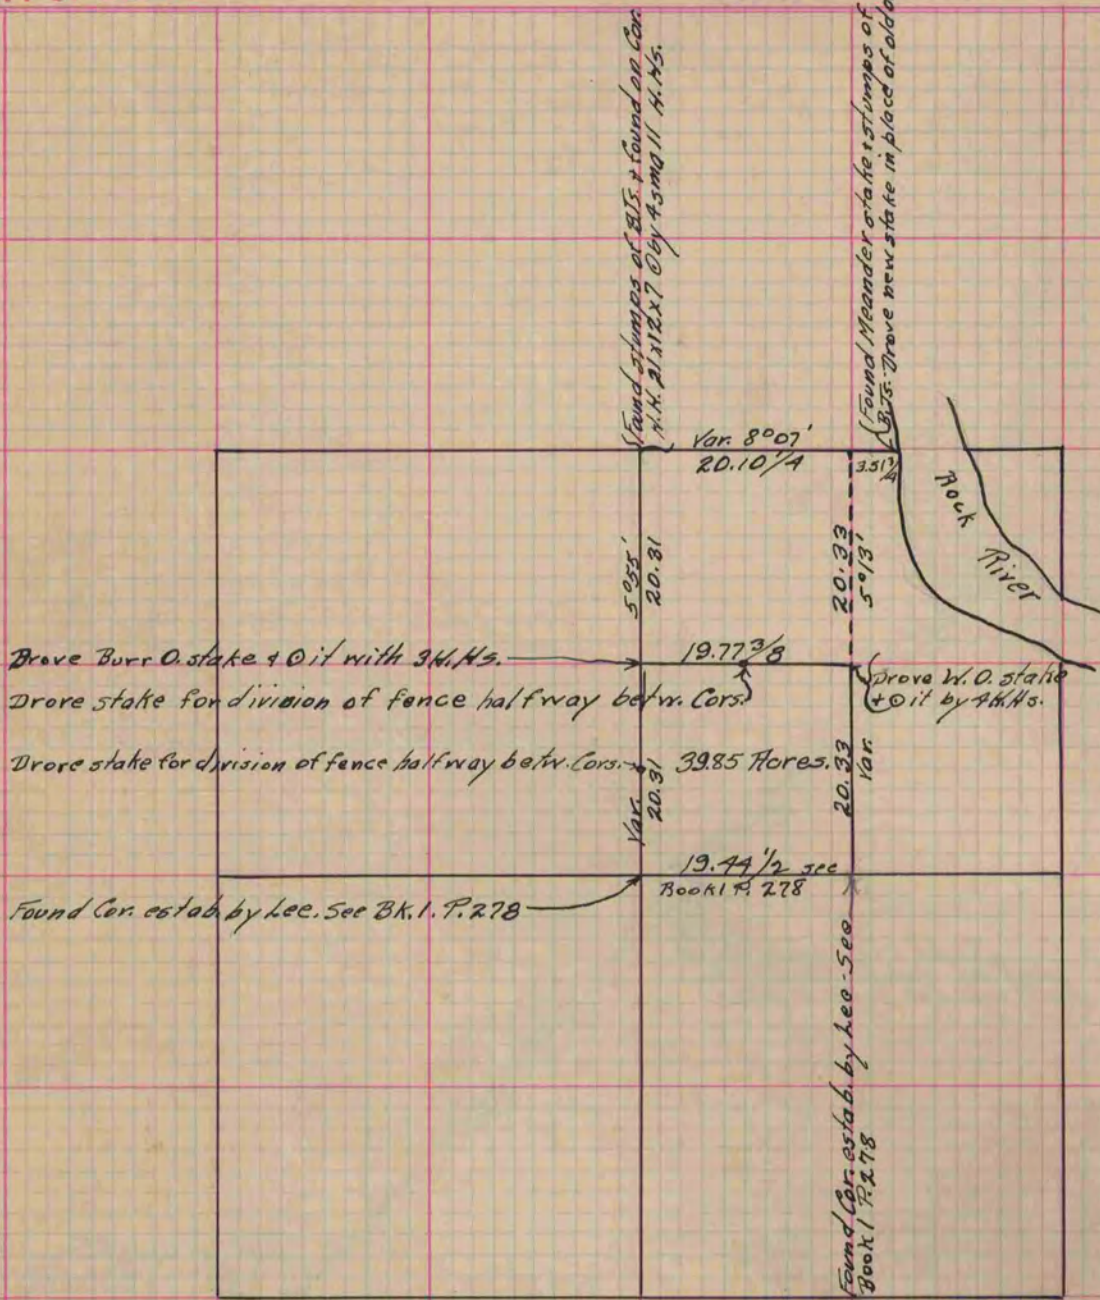

Copied from Page 64 Vol. 2. Original County Surveyor's Record.